

For KCC Use:  
Effective Date: 4-17-07  
District # 1  
SGA?  Yes  No

KANSAS CORPORATION COMMISSION  
OIL & GAS CONSERVATION DIVISION

Location Correction Form C-1

December 2002

NOTICE OF INTENT TO DRILL **CORRECTED**

Form must be Typed  
Form must be signed  
All blanks must be Filled

Must be approved by KCC five (5) days prior to commencing well

Expected Spud Date 05/24/07  
month day year

Spot:  East  West  
NW - SW - NE Sec. 7 Twp. 33S R. 43

OPERATOR: License # 5447

1775.0 feet from  N /  S Line of Section

Name: OXY USA Inc.

\* 2212.1 feet from  E /  W Line of Section

Address: P.O. Box 2528

Is SECTION  Regular  Irregular

City/State/Zip: Liberal, KS 67905

(Note: Locate well on the Section Plat on reverse side)

Contact Person: Kenny Andrews

County: Morton

Phone: (620) 629-4200

Lease Name: Neill D Well #: 1

CONTRACTOR: License # 30606

Field Name: Turnmorrow

Name: Murfin Drilling Inc.

Is this a Prorated / Spaced Field?  Yes  No

Target Formation(s): Mississippian

Nearest Lease or unit Boundary: 873.8'

Well Drilled For: Well Class: Type Equipment:

Ground Surface Elevation: 3664.4 feet MSL

Oil  Enh Rec  Infield  Mud Rotary

Water well within one-quarter mile  Yes  No

Gas  Storage  Pool Ext  Air Rotary

Public water supply well within one mile:  Yes  No

OWWO  Disposal  Wildcat  Cable

Depth to bottom of fresh water: 280

Seismic: # of Holes  Other

Depth to bottom of usable water: 280

Other

Surface Pipe by Alternate:  1  2

If OWWO: old well information as follows:

Length of Surface Pipe Planned to be set: 1750

Operator: \_\_\_\_\_

Length of Conductor Pipe Required: \_\_\_\_\_

Well Name: \_\_\_\_\_

Projected Total Depth: 5100

Original Completion Date: \_\_\_\_\_ Original Total Depth: \_\_\_\_\_

Formation at Total Depth: Mississippian

Directional, Deviated or Horizontal wellbore?  Yes  No

Water Source for Drilling Operations:  Well  Farm Pond  Other

IF Yes, true vertical depth \_\_\_\_\_

DWR Permit # \_\_\_\_\_

Bottom Hole Location \_\_\_\_\_

(Note: Apply for Permit with DWR )

KCC DKT #: \_\_\_\_\_

Will Cores be Taken?  Yes  No

If Yes, Proposed zone: \_\_\_\_\_

\*WAG: 2300' FEL  
IS: 2212.1 FEL

AFFIDAVIT

The undersigned hereby affirms that the drilling, completion and eventual plugging of this well will comply with K.S.A. 55-101, et. Seq.  
It is agreed that the following minimum requirements will be met:

1. Notify the appropriate district office **prior** to spudding of well;
2. A copy of the approved notice of intent to drill **shall be posted** on each drilling rig;
3. The minimum amount of surface pipe as specified below **shall be set** by circulating cement to the top; in all cases surface pipe **shall be set** through all unconsolidated materials plus a minimum of 20 feet into the underlying formation.
4. If the well is dry hole, an agreement between the operator and the district office on plug length and placement is necessary **prior to plugging**;
5. The appropriate district office will be notified before well is either plugged or production casing is cemented in;
6. If an ALTERNATE II COMPLETION, production pipe shall be cemented from below any usable water to surface within **120 days** of spud date. Or pursuant to Appendix "B" - Eastern Kansas surface casing order #133,891-C, which applies to the KCC District 3 area, alternate II cementing must be completed within 30 days of the spud date or the well shall be plugged. **In all cases, NOTIFY district office** prior to any cementing.

I hereby certify that the statements made herein are true and to the best of my knowledge and belief.

Date: 02/05/08 Signature of Operator or Agent: \_\_\_\_\_ Title: Production Lead

For KCC Use ONLY

API # 15 - 129-21805-0000

Conductor pipe required None feet

Minimum Surface pipe required 300 feet per Alt. 1

Approved by: WHM 4-12-07 / WHM 4-13-07 / Paul 2-11-08

This authorization expires: 10-12-07

(This authorization void if drilling not started within 6 months of effective date.)

Spud date: \_\_\_\_\_ Agent: \_\_\_\_\_

Remember to:

- File Drill Pit Application (form CDP-1) with Intent to Drill
- File Completion Form ACO-1 within 120 days of spud date;
- File acreage attribution plat according to field proaction orders;
- Notify appropriate district office 48 hours prior to workover or re-entry;
- Submit plugging report (CP-4) after plugging is completed;
- Obtain written approval before disposing or injecting salt water.
- If this permit has expired (see: authorized expiration date) please check the box below and return to the address below.

Well Not Drilled - Permit Expired

Signature of Operator or Agent: \_\_\_\_\_

Date: \_\_\_\_\_

Mail to: KCC - Conservation Division, 130 S. Market - Room 2078, Wichita, Kansas 67202

RECEIVED

KANSAS CORPORATION COMMISSION

FEB 07 2008

CONSERVATION DIVISION  
WICHITA, KS

**IN ALL CASES PLOT THE INTENDED WELL ON THE PLAT BELOW**

*Plat of acreage attributable to a well in a prorated or spaced field*

**CORRECTED**

*If the intended well is in a prorated or spaced field, please fully complete this side of the form. If the intended well is in a prorated or spaced field complete the plat below showing that the well will be properly located in relationship to other wells producing from the common source of supply. Please show all the wells and within 1 mile of the boundaries of the proposed acreage attribution unit for gas wells and within 1/2 mile of the boundaries of the proposed acreage attribution unit for oil wells.*

API No. 15 - \_\_\_\_\_  
Operator: \_\_\_\_\_  
Lease: \_\_\_\_\_  
Well Number: \_\_\_\_\_  
Field: \_\_\_\_\_

Location of Well: County \_\_\_\_\_  
\_\_\_\_\_ feet from  N /  S Line of Section  
\_\_\_\_\_ feet from  E /  W Line of Section  
Sec. \_\_\_\_\_ Twp. \_\_\_\_\_ R. \_\_\_\_\_  East  West

Is Section  Regular or  Irregular



Number of Acres attributable to well: \_\_\_\_\_  
QTR / QTR / QTR of acreage: \_\_\_\_\_ - \_\_\_\_\_ - \_\_\_\_\_

**IF Section is Irregular, locate well from nearest corner boundary.**

Section corner used:  NE  NW  SE  SW

**PLAT**

*(Show location of the well and shade attributable acreage for prorated or spaced wells.)  
(Show footage to the nearest lease or unit boundary line.)*

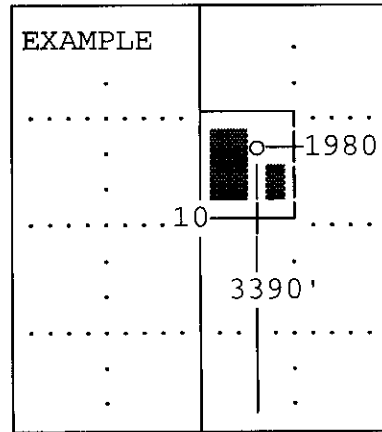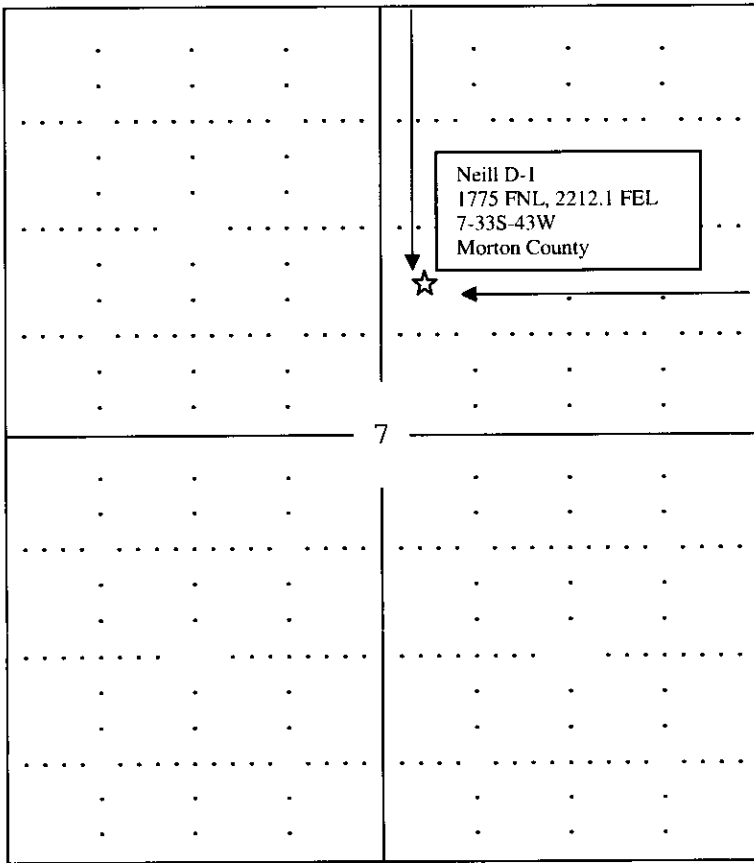

SEWARD CO.

RECEIVED  
KANSAS CORPORATION COMMISS

FEB 07 2008

CONSERVATION DIVISION  
WICHITA, KS

**Note: In all cases locate the spot of the proposed drilling location.**

**In plotting the proposed location of the well, you must show:**

1. The manner in which you are using the depicted plat by identifying section lines, i.e. 1 section, 1 section with 8 surrounding sections, 4 sections, etc.
2. The distance of the proposed drilling location from the sections south / north and east / west.
3. The distance to the nearest lease or unit boundary line.
4. If proposed location is located within a prorated or spaced field a certificate of acreage attribution plat must be attached: (CO-7 for oil wells; CG-8 for gas wells).