

STATE OF KANSAS  
STATE CORPORATION COMMISSION


WELL PLUGGING RECORD

Give All Information Completely  
Make Required Affidavit  
Mail or Deliver Report to:  
Conservation Division  
State Corporation Commission  
800 Bitting Building  
Wichita, Kansas

Graham County. Sec. 33 Twp. 9S Rge. (E) 21 (W)

Location as "NE/CNW/SW" or footage from lines NW NE SW  
Lease Owner Westgate-Greenland Oil Company  
Lease Name Frazier Well No. 1  
Office Address 1009 Central Building, Wichita, Kansas  
Character of Well (completed as Oil, Gas or Dry Hole) dry hole  
Date well completed February 21, 1953 19  
Application for plugging filed February 21, 1953 (orally) 19  
Application for plugging approved February 24, 1953 (written) 19  
Plugging commenced February 21, 1953 19  
Plugging completed February 21, 1953 19  
Reason for abandonment of well or producing formation \_\_\_\_\_

NORTH

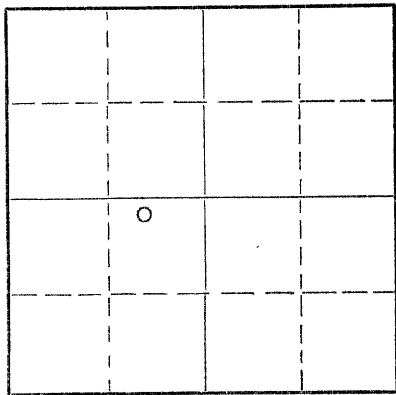

Locate well correctly on above  
Section Plat

If a producing well is abandoned, date of last production \_\_\_\_\_ 19  
Was permission obtained from the Conservation Division or its agents before plugging was commenced? yes

Name of Conservation Agent who supervised plugging of this well Eldon Petty  
Producing formation \_\_\_\_\_ Depth to top \_\_\_\_\_ Bottom \_\_\_\_\_ Total Depth of Well \_\_\_\_\_ Feet  
Show depth and thickness of all water, oil and gas formations.

OIL, GAS OR WATER RECORDS

CASING RECORD

FORMATION	CONTENT	FROM	TO	SIZE	PUT IN	PULLED OUT
surface		0	174	8 5/8"	174	one

Describe in detail the manner in which the well was plugged, indicating where the mud fluid was placed and the method or methods used in introducing it into the hole. If cement or other plugs were used, state the character of same and depth placed, from \_\_\_\_\_ feet to \_\_\_\_\_ feet for each plug set.

Filled hole with heavy mud from 3975 to 165 feet  
Set plug and ran 15 sacks cement from 165 feet to 115 feet  
Filled with heavy mud from 115 to 40 feet  
Set plug at 40 feet and capped with 10 sacks cement to cellar.

(If additional description is necessary, use BACK of this sheet)

Name of Plugging Contractor Westgate Drilling Corporation  
Address 1009 Central Building, Wichita 2, Kansas

STATE OF Kansas, COUNTY OF Sedgwick, ss.  
Harold A. Burt


(employee of owner) or (owner or operator) of the above-described well, being first duly sworn on oath, says: That I have knowledge of the facts, statements, and matters herein contained and the log of the above-described well as filed and that the same are true and correct. So help me God.

(Signature) Harold A. Burt  
1009 Central Building, Wichita, Kans  
(Address)

SUBSCRIBED AND SWORN TO before me this 27th day of February 19 53

My commission expires May 25, 1953.

Esther Russell  
2/28/53 Public.

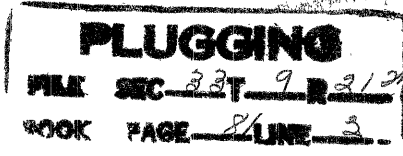

## DRILLER'S LOG

COMPANY: Westgate-Greenland Oil Company  
 CONTRACTOR: Westgate Drilling Corporation  
 FARM: Frazier #1, NW NE SW 33-9S-21W,  
 Graham County, Kansas  
 COMMENCED: February 10, 1953  
 COMPLETED: February 21, 1953  
 ELEVATION: 2315 DF

0	to	100	Soil, clay W/gr & sd
100	to	174	Shale
174	to	920	Shale and shells
920	to	1530	Shale and sand
1530	to	1789	Red bed W/shale & sand
1789	to	1830	Anhydrite
1830	to	2160	Shale and shells
2160	to	3220	Shale and lime
3220	to	3315	Lime W/shale breaks
3315	to	3463	Lime and shale
3463	to	3519	Lime W/shale breaks
3519	to	3523	Shale
3523	to	3560	Lime and Shale
3560	to	3793	Lime
3793	to	3845	Shale and lime
3845	to	3865	Shale-lime W/chert
3865	to	3881	Shale
3881	to	3912	Shale-lime and chert
3912	to	3949	Conglomerate and chert
3949	to	3970	Conglomerate
3970	to	3975	Chert
		3975	T. D. (RB)

Set 174 feet of 8 5/8" 24# surface. Cemented with 125 sacks cement and 2 sacks calcium chloride.

DRILL STEM TEST 3579-3607, 1 hour, weak blow for 4 min. recovered 25 feet mud, 780# BHP.

TOPS:	Anhydrite	1786	Lansing	3557	Marm.	3845
	Heebner	3518	Base KC	3784	Conglomerate	3909
	Toronto	3540				

No Schlumberger run.

DRY, PLUGGED AND ABANDONED

C E R T I F I C A T E

I, Don Allen, do hereby certify that the above and foregoing is a true and correct copy of log of the Frazier #1, NW NE SW Section 33-9-21W, Graham County, Kansas, as reflected by files of the Westgate-Greenland Oil Company.

*Don Allen*  
 Don Allen

Subscribed and sworn to before me, a Notary Public, within and for Sedgwick County, Kansas, this 26th day of February, 1953.

*Esther Unsell*  
 Esther Unsell, Notary Public

My commission expires May 25, 1953.

