

RECEIVED  
STATE CORPORATION COMMISSION  
11/11/74  
NOV 11 1974

CONSERVATION DIVISION  
Wichita, Kansas


FORM CP-4

STATE OF KANSAS  
STATE CORPORATION COMMISSION  
CONSERVATION DIVISION  
P. O. BOX 17027  
WICHITA, KANSAS 67217

WELL PLUGGING RECORD

Graham County, Sec. 35 Twp. 9 Rge. (E) 21(W)

Location as "NE/CNW/SW" or footage from lines SW SW SW  
Lease Owner C-G Drilling Company  
Lease Name DeYoung Well No. 1  
Office Address 1107 Union National Bldg., Wichita, Kansas  
Character of Well (completed as Oil, Gas or Dry Hole) oil 67202  
Date well completed July 23 19 50  
Application for plugging filed Oct. 16 19 74  
Application for plugging approved 19  
Plugging commenced Oct. 18 19 74  
Plugging completed Oct. 30 19 74  
Reason for abandonment of well or producing formation depleted

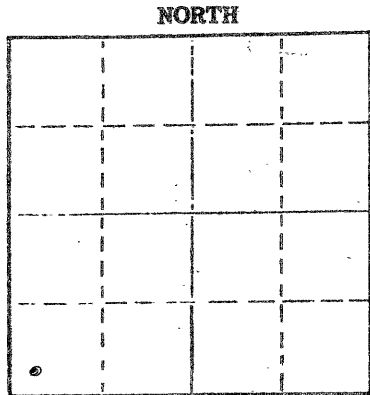

Locate well correctly on above Section Plat

If a producing well is abandoned, date of last production 19  
Was permission obtained from the Conservation Division or its agents before plugging was commenced? yes

Name of Conservation Agent who supervised plugging of this well W. L. Nichols  
Producing formation \_\_\_\_\_ Depth to top \_\_\_\_\_ Bottom \_\_\_\_\_ Total Depth of Well 3834 Feet  
Show depth and thickness of all water, oil and gas formations.

OIL, GAS OR WATER RECORDS

CASING RECORD

FORMATION	CONTENT	FROM	TO	SIZE	PUT IN	PULLED OUT
			234'	8 5/8"	234'	none
			3831'	5 1/2"	3831'	813.36

Describe in detail the manner in which the well was plugged, indicating where the mud fluid was placed and the method or methods used in introducing it into the hole. If cement or other plugs were used, state the character of same and depth placed, from \_\_\_\_\_ feet to \_\_\_\_\_ feet for each plug set.

Sanded back to 3815' and dumped 5 sacks of cement.

Allied Cementing Company plugged well pumping in 5 sacks of hulls, 25 sacks of gel and 100 sacks of cement.

Name of Plugging Contractor PIPE PULLERS, INC. (If additional description is necessary, use BACK of this sheet)  
Address Box 128, Ellinwood, Kansas 67526

STATE OF KANSAS COUNTY OF BARTON ss.  
Evelyn Roth

(employee of owner) or (owner or operator) of the above-described well, being first duly sworn on oath, says: That I have knowledge of the facts, statements, and matters herein contained and the log of the above-described well as filed and that the same are true and correct. So help me God.

(Signature) Evelyn Roth  
Ellinwood, Kansas (Address)

Subscribed and Sworn to before me this 8th day of November, 1974

My commission expires

JENNY KASSELMAN  
NOTARY PUBLIC  
BARTON COUNTY, KANSAS  
MY COMM. EXP. JULY 16, 1978

Jenny Kasselmann  
Notary Public

KANSAS WELL LOG BUREAU --- KANSAS GEOLOGICAL SOCIETY  
508 EAST MURDOCK - WICHITA, KANSAS

**COPY**

15-065-00224-00-00

COMPANY C-G DRILLING CO., INC.


SEC. 35 T. 9 R. 21W

FARM De Young NO. 1

LOC. SW SW SW

TOTAL DEPTH 3831 *5 1/2" casing set*  
 COMM. 7-12-50 COMP. 7-23-50  
 SHOT OR TREATED  
 CONTRACTOR  
 ISSUED 11-4-50

COUNTY Graham  
KANSAS

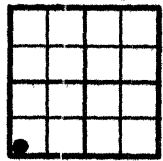

CASING

8 5/8" 234.02'  
 5 1/2" 3834.73' *TD*

ELEVATION 2273 DF

PRODUCTION Draw Down 3000 bbl.s.

FIGURES INDICATE BOTTOM OF FORMATIONS

ALL MEASUREMENTS FROM TOP OF ROTARY BUSHING:

no log	0-235
shale	655
shale, shells	860
sand	950
shale, shells	1030
sand, shells	1185
shale, sand	1270
sand	1485
shale, shells	1640
shale, red bed	1695
shale, shells	1752
anhydrite	1787
shale, shells	2000
lime, shale	2480
lime brkn	2615
lime, shale	3285
lime	3831
Total depth	

Tops; Scout	
Anhydrite	1752
Topeka	3265
Heebner	3469
Toronto	3488
Base Kansas City	3732
Conglomerate	3783
Simpson shale	3801
Simpson dolomite	3811
Arbuckle	3823

RECEIVED  
 STATE CORPORATION COMMISSION  
 OCT 17 1974  
 CONSERVATION DIVISION  
 Wichita, Kansas