


WELL PLUGGING RECORD

Give All Information Completely
Make Required Affidavit
Mail or Deliver Report to:
Conservation Division
State Corporation Commission
800 Biting Building
Wichita, Kansas

Graham County. Sec. 35 Twp. 9 Rge. 21 ~~(E)~~ W (W)
Location as "NE/CNW $\frac{1}{4}$ /SW $\frac{1}{4}$ " or footage from lines SE NW SW
Lease Owner C-G DRILLING CO.
Lease Name De YOUNG Well No. 4-B
Office Address 206 Union Nat'l. Bank Bldg., Wichita, Kansas
Character of Well (completed as Oil, Gas or Dry Hole) Dry Hole
Date well completed March 5, 19 52
Application for plugging filed March 5, 19 52
Application for plugging approved March 5, 19 52
Plugging commenced March 5, 19 52
Plugging completed March 5, 19 52
Reason for abandonment of well or producing formation Too low structurally.

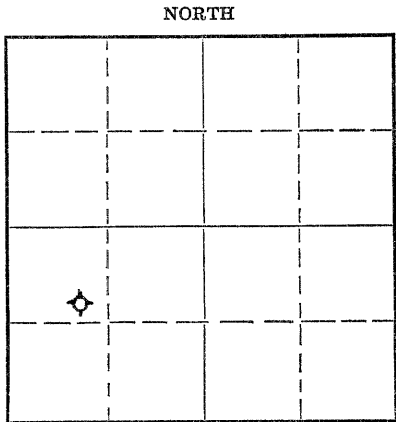

Locate well correctly on above Section Plat

If a producing well is abandoned, date of last production ----- 19 ____
Was permission obtained from the Conservation Division or its agents before plugging was commenced? Yes

Name of Conservation Agent who supervised plugging of this well Eldon Petty, Hays, Kansas.
Producing formation ----- Depth to top ----- Bottom ----- Total Depth of Well ----- Feet
Show depth and thickness of all water, oil and gas formations.

OIL, GAS OR WATER RECORDS

CASING RECORD

Formation	Content	From	To	Size	Put In	Pulled Out
				8 5/8"	148.73'	

Describe in detail the manner in which the well was plugged, indicating where the mud fluid was placed and the method or methods used in introducing it into the hole. If cement or other plugs were used, state the character of same and depth placed, from ----- feet to ----- feet for each plug set.

Filled with drilling mud to 145'. Set plug. Put in 15 sacks cement and 1/2 sack Hulls; pumped full of mud to 40'. Drove plug. Filled to top with 10 sacks cement and 1/2 sack hulls.

(If additional description is necessary, use BACK of this sheet)


Name of Plugging Contractor C-G DRILLING CO.
Address 206 Union National Bank Building, Wichita, Kansas.

STATE OF KANSAS, COUNTY OF SEDGWICK, ss.
Vicky Fritz (employee of owner) or (~~owner or operator~~) of the above-described well, being first duly sworn on oath, says: That I have knowledge of the facts, statements, and matters herein contained and the log of the above-described well as filed and that the same are true and correct. So help me God.

(Signature) Vicky Fritz
206 Union Nat'l. Bank Bldg., Wichita, Ks.
(Address)

SUBSCRIBED AND SWORN to before me this 7th day of March, 19 52
Marilyn Schmidt
Notary Public.

My commission expires November 21, 1955
23-8390-s 6-51-20M

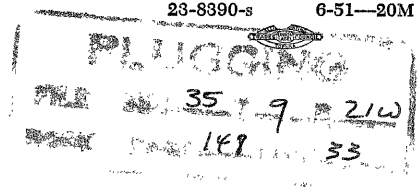

3/8/52

CONTRACTOR'S WELL LOG

OPERATOR C-G DRILLING CO. FARM NAME DeYOUNG #4-B
 LOCATION SE NW SW Sec. 35-9-21W
 POOL NAME Cooper COUNTY Graham STATE Kansas
 COMMENCEMENT DATE February 23, 1952 COMPLETION DATE March 5, 1952

LOG OF WELL

Elevation: 2297 R. B.
 All measurements from the top of rotary bushing.


FROM	TO	FORMATION	DEVIATION FROM VERTICAL	REMARKS:
0	149			
149	550	Shale		
550	875	Shale-Sand		
875	950	Sand		
950	1140	Shale-Sand		
1140	1290	Shale		
1290	1490	Sand		
1490	1590	Red Bed	0° - 1500'	
1590	1762	Red Bed		
1762	1802	Anhydrite		
1802	1880	Shale-Shells		
1880	2090	Shale-Shells	0° - 2000'	
2090	2280	Shale		
2280	2350	Shale-Lime		
2350	2450	Lime-Shale		
2450	2530	Lime-Shale	0° - 2500'	
2530	2625	Lime-Shale		
2625	2685	Lime-Shale		
2685	2800	Lime-Shale		
2800	2885	Lime-Shale		
2885	2950	Lime-Shale		
2950	3010	Lime-Shale	0° - 3000'	
3010	3075	Lime-Shale		
3075	3130	Lime-Shale		
3130	3240	Lime-Shale		
3240	3345	Lime-Shale		
3345	3430	Lime		
3430	3490	Lime-Shale		
3490	3550	Lime	0° 3500'	
3550	3599	Lime		
3599	3635	Lime		
3635	3680	Lime		
3680	3720	Lime		
3720	3760	Lime		
3760	3840	Lime-Shale		
3840	3870	Lime-Shale	3870	
3870	3900	Conglomerate	2297 7573	

CASING LEFT IN HOLE AFTER COMPLETION

Ran 148.73' (7 jts.) 8 5/8" OD Casing.

STATE OF KANSAS, COUNTY OF SEDGWICK) ss.

The undersigned certifies that to the best of her knowledge and belief, the above facts are true and correct.

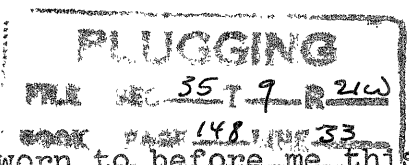

C-G DRILLING CO.
 By Vicky Lutz

Subscribed and sworn to before me this 7th day of March, 1952.

My commission expires: 11-21-55

Marilyn Schmidt