


Give All Information Completely  
Make Required Affidavit  
Mail or Deliver Report to:  
Conservation Division  
State Corporation Commission  
800 Bitting Building  
Wichita, Kansas

WELL PLUGGING RECORD

Graham County, Sec. 35 Twp. 9 Rge. 21 (E) W (W)

Location as "NE/CNW/SW" or footage from lines NE NW NE  
Lease Owner C-G Drilling Co.  
Lease Name De Young "B" Well No. 1  
Office Address 107 Rule Building  
Character of Well (completed as Oil, Gas or Dry Hole) Dry Hole  
Date well completed 2-23 19 55  
Application for plugging filed 2-23 19 55  
Application for plugging approved 2-23 19 55  
Plugging commenced 2-23 19 55  
Plugging completed 2-23 19 55  
Reason for abandonment of well or producing formation Too low structurally

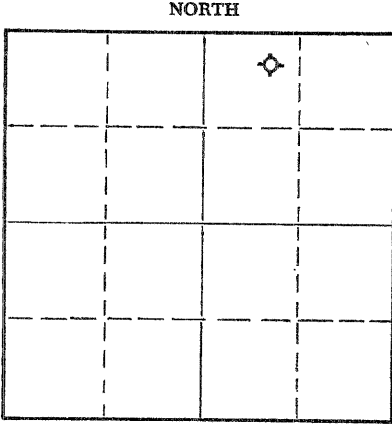

Locate well correctly on above Section Plat

If a producing well is abandoned, date of last production -- 19 --  
Was permission obtained from the Conservation Division or its agents before plugging was commenced? Yes

Name of Conservation Agent who supervised plugging of this well Eldon Petty, Hays, Kansas  
Producing formation -- Depth to top -- Bottom -- Total Depth of Well 3915 Feet  
Show depth and thickness of all water, oil and gas formations.

OIL, GAS OR WATER RECORDS

CASING RECORD

FORMATION	CONTENT	FROM	TO	SIZE	PUT IN	PULLED OUT
				8-5/8"	184.83'	

Describe in detail the manner in which the well was plugged, indicating where the mud fluid was placed and the method or methods used in introducing it into the hole. If cement or other plugs were used, state the character of same and depth placed, from feet to feet for each plug set.

Filled hole with mud to 180'; set plug;  
1/2 sacks hulls, 15 sacks cement. Filled  
hole with mud to 40'; set plug then filled  
to top with 10 sacks cement, 1/2 sack hulls.

(If additional description is necessary, use BACK of this sheet)

Name of Plugging Contractor C-G DRILLING CO.  
Address 107 Rule Building, Wichita, Kansas

STATE OF KANSAS, COUNTY OF SEDGWICK, ss.  
Vicky Jacobs (employee of owner) or (owner/operator) of the above-described

well, being first duly sworn on oath, says: That I have knowledge of the facts, statements, and matters herein contained and the log of the above-described well as filed and that the same are true and correct. So help me God.

(Signature) Vicky Jacobs  
Office Manager  
107 Rule Building, Wichita, Kansas  
(Address)

SUBSCRIBED AND SWORN TO before me this 25th day of February, 1955

Barbara Donaldson  
Notary Public.

My commission expires June 17, 1957

PLUGGING  
FILE SEC 35 T 9 R 21 W  
BOOK PAGE 99 LINE 36

STATE CORPORATION COMMISSION  
2/26/55  
FEB 26 1955  
CONSERVATION DIVISION  
WICHITA, KANSAS

CONTRACTOR'S WELL LOG

OPERATOR C-G Drilling Co. FARM NAME De Young "B" Well #1  
 LOCATION NE NW NE, Section 35-9-21W  
 POOL NAME \_\_\_\_\_ COUNTY Graham STATE Kansas  
 COMMENCEMENT DATE 2-15-55 COMPLETION DATE 2-23-55

LOG OF WELL

Elevation: 2306 R. B.  
 All measurements from the top of rotary bushing.

FROM	TO	FORMATION	DEVIATION FROM VERTICAL	REMARKS:
0	184	Shale		
184	300	Shale		
300	1350	Shale-Shells-Sand		
1350	1788	Shale-Red Bed		
1788	1830	Anhydrite		
1830	1880	Shale		
1880	2300	Shale-Lime	0° - 2000'	
2300	2510	Lime-Shale	0° - 2500'	
2510	2645	Lime-Shale		
2645	2845	Lime-Shale		
2845	2965	Lime-Shale		
2965	3065	Lime-Shale	0° - 3000'	
3065	3225	Lime-Shale		
3225	3345	Lime-Shale		
3345	3430	Lime-Shale		
3430	3500	Lime-Shale	0° - 3500'	
3500	3585	Lime-Shale		
3585	3630	Lime-Shale		
3630	3680	Lime-Shale		
3680	3730	Lime-Shale		
3730	3775	Lime-Shale		
3775	3820	Lime-Shale		
3820	3870	Lime-Shale		
3870	3915	Lime-Shale		

CASING LEFT IN HOLE AFTER COMPLETION

Ran 184.83' of 8-5/8" Surface Casing.

STATE OF KANSAS, COUNTY OF SEDGWICK ) ss.

The undersigned certifies that to the best of her knowledge and belief, the above facts are true and correct.

C-G DRILLING CO.

By *Dicky Jacobs*  
 Office Manager

Subscribed and sworn to before me this 25th day of February, 1955.

My commission expires: June 17, 1957

*Barbara Donaldson*  
 Notary Public

