


WELL PLUGGING RECORD

Give All Information Completely
Make Required Affidavit
Mail or Deliver Report to:
Conservation Division
State Corporation Commission
800 Bittling Building
Wichita, Kansas

NORTH

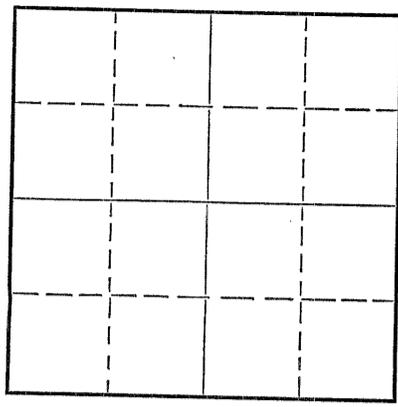

Locate well correctly on above
Section Plat

Graham County. Sec. 14 Twp 9 S Rge. 22 (E).....(W)
Location as "NE/CNW $\frac{1}{4}$ SW $\frac{1}{4}$ " or footage from lines NW $\frac{1}{4}$ NW $\frac{1}{4}$ NE $\frac{1}{4}$
Lease Owner Barnett Oil Company
Lease Name Van Loenen Well No. I
Office Address 117 First National Bank Building, Wichita, Kansas
Character of Well (completed as Oil, Gas or Dry Hole) Dry Hole
Date well completed February 19, 1951
Application for plugging filed February 19, 1951
Application for plugging approved February 19, 1951
Plugging commenced February 19, 1951
Plugging completed February 19, 1951
Reason for abandonment of well or producing formation Dry Hole

If a producing well is abandoned, date of last production..... 19.....
Was permission obtained from the Conservation Division or its agents before plugging was commenced? Yes

Name of Conservation Agent who supervised plugging of this well Eldon Petty
Producing formation..... Depth to top..... Bottom..... Total Depth of Well 3886 Feet
Show depth and thickness of all water, oil and gas formations.

OIL, GAS OR WATER RECORDS

CASING RECORD

Formation	Content	From	To	Size	Put In	Pulled Out
Surface Pipe		0	142 ft.	8 5/8"	142 ft.	None

Describe in detail the manner in which the well was plugged, indicating where the mud fluid was placed and the method or methods used in introducing it into the hole. If cement or other plugs were used, state the character of same and depth placed, from..... feet to..... feet for each plug set.

Filled hole with heavy mud from 3886 feet to 142 feet. Set wooden plug at 140 feet.
Filled with $\frac{1}{2}$ sack of hulls and 15 sacks of cement to 93 feet. Filled with heavy mud to 40 feet. Set top wooden plug. Dumped $\frac{1}{2}$ sack of hulls on plug and filled to bottom of cellar with 10 sacks of cement.

RECEIVED
STATE CORPORATION COMMISSION
2/23/51
FEB 23 1951
CONSERVATION DIVISION
WICHITA, KANSAS

(If additional description is necessary, use BACK of this sheet)

Correspondence regarding this well should be addressed to Barnett Oil Company
Address 117 First National Bank Building, Wichita, Kansas

STATE OF KANSAS, COUNTY OF SEDGWICK, ss.
W. E. Cruce

(employee of owner) or (owner or operator) of the above-described well, being first duly sworn on oath, says: That I have knowledge of the facts, statements, and matters herein contained and the log of the above-described well as filed and that the same are true and correct. So help me God.

(Signature) W. E. Cruce

117 First National Bank Building, Wichita, Ks.
(Address)

SUBSCRIBED AND SWORN to before me this 22nd day of February, 1951

My commission expires May 12, 1951
Adelaide Olwin
Notary Public.

23-5091-s 8-50-10M
PLUGGING
FILE SEC 14 T 9 R 22
PAGE 63 UNIT 19

BARNETT OIL COMPANY, ET AL.
LOG OF VAN LOENEN WELL NO. 1
NW $\frac{1}{4}$ NW $\frac{1}{4}$ NE $\frac{1}{4}$ SECTION 11-9S-22W, GRAHAM COUNTY, KANSAS.

DATE COMMENCED: February 5, 1951

DATE COMPLETED: February 19, 1951

<u>Formation</u>	<u>From</u>	<u>To</u>	<u>Remarks</u>
Surface Clay	0	70	
Sand	70	90	
Shale and Shells	90	112	Set 8 5/8" Surface Pipe @ 112 feet; cemented with 125 sacks.
Shale and Shells	112	1275	
Sand	1275	1505	
Red Bed and Shale	1505	1600	
Shale and Shells	1600	1760	
Anhydrite	1760	1797	
Shale and Shells	1797	2210	
Lime and Shale	2210	2820	
Shale	2820	2870	
Shale and Lime	2870	3110	
Lime	3110	3753	
Shale and Lime	3753	3815	
Lime	3815	3886	
Total Depth		3886	Dry and abandoned.

Certificate.

I, W. E. Cruce, of Barnett Oil Company, hereby certify that to the best of my knowledge and belief, the above is a true and correct log of the Van Loenen Well No. 1, located in the NW $\frac{1}{4}$ NW $\frac{1}{4}$ NE $\frac{1}{4}$ of Section 11-9S-22W, Graham County, Kansas.

W. E. Cruce

Subscribed and sworn to before me, in and for the County of Sedgwick, State of Kansas, this 22nd day of February, 1951.

Adelaide Olivier
Notary Public

My commission expires May 12, 1951.

RECEIVED
STATE CORPORATION COMMISSION
FEB 23 1951
CONSERVATION DIVISION
Topeka, Kansas

PLUGGING
FILE SEC 14T 9 R 22W
BOOK PAGE 63 LINE 19