

STATE OF KANSAS  
STATE CORPORATION COMMISSION


Give All Information Completely  
Make Required Affidavit  
Mail or Deliver Report to:  
Conservation Division  
State Corporation Commission  
211 No. Broadway  
Wichita, Kansas

WELL PLUGGING RECORD

Graham County, Sec. 14 Twp. 9S Rge. 22W ~~XXXXXXXXXX~~

Location as "NE/CNW%SW%" or footage from lines NE SE SW  
Lease Owner PRODUCERS OIL COMPANY  
Lease Name SANDZEN "A" Well No. 1  
Office Address 711 Philtower Building, Tulsa, Oklahoma  
Character of Well (completed as Oil, Gas or Dry Hole) Oil Well  
Date well completed July 1957  
Application for plugging filed October 1967  
Application for plugging approved Renewed 2/23 1968  
Plugging commenced 2/24 1968  
Plugging completed 2/25 1968  
Reason for abandonment of well or producing formation Depleted

NORTH

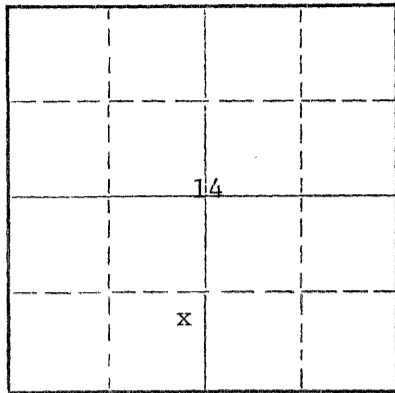

Locate well correctly on above  
Section Plat

If a producing well is abandoned, date of last production Feb. 1968  
Was permission obtained from the Conservation Division or its agents before plugging was commenced? Yes

Name of Conservation Agent who supervised plugging of this well W. L. Nichols  
Producing formation Lansing K.C. Depth to top 3523 Bottom \_\_\_\_\_ Total Depth of Well 3860 Feet  
Show depth and thickness of all water, oil and gas formations.

OIL, GAS OR WATER RECORDS

CASING RECORD

FORMATION	CONTENT	FROM	TO	SIZE	PUT IN	PULLED OUT
Kansas City Lime	oil	3611	3615	5-1/2	3857	916.71
				8-5/8	237	

Describe in detail the manner in which the well was plugged, indicating where the mud fluid was placed and the method or methods used in introducing it into the hole. If cement or other plugs were used, state the character of same and depth placed, from \_\_\_\_\_ feet to \_\_\_\_\_ feet for each plug set.

Made bottom hole plug back with sand to 3450'. Mixed and ran 5 sacks cement through dump bailer.

Mixed and pumped 35 sacks gel with 5 sacks hulls followed with 130 sacks cement.

RECEIVED  
STATE CORPORATION COMMISSION  
MAR 21 1968  
CONSERVATION DIVISION  
Wichita, Kansas

(If additional description is necessary, use BACK of this sheet)

Name of Plugging Contractor Allied Cementing Company  
Address Russell, Kansas

STATE OF OKLAHOMA, COUNTY OF TULSA, ss.  
R. E. COUCH

(employee of owner) or (owner or operator) of the above-described well, being first duly sworn on oath, says: That I have knowledge of the facts, statements, and matters herein contained and the log of the above-described well as filed and that the same are true and correct. So help me God.


(Signature) R. E. Couch  
711 Philtower Building, Tulsa, Oklahoma

SUBSCRIBED AND SWORN TO before me this 7th day of March, 19 68

My commission expires 7/1/71 Charlotte Lucas Notary Public.

XERO COPY XERO COPY XERO COPY XERO COPY

Veeder Supply & Dev'l. Co.

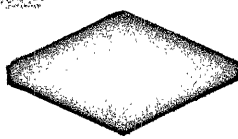

Cherryvale, Kansas

Drilled for Producers Pipe & Supply Co. Farm Sandzen No. 1 Depth 3860  
 Contractor Veeder Supply & Development Co. Pipe 237' 8 5/8" csg w/140 sacks  
3857' 5 1/2" csg. w/140 sacks  
 Location NE/4 SE/4 SW/4 Sec. 14 Twp. 9S Range 22W  
 Commenced 6-27-57 Completed 7-13-57 County Graham State Kansas

Rock	0	30	30
Sand, shale	30	80	50
Grey Shale	80	237	157
Shale	237	875	638
Shale and sand	875	1585	710
Shale, shells, red bed	1585	1808	223
Anhydrite	1808	1850	42
Shale and shells	1850	2225	375
Shale & lime strks.	2225	2375	150
Lime and shale	2375	3055	680
Shale lime	3055	3160	105
Lime and shale	3160	3295	135
Shale lime	3295	3365	70
Lime	3365	3570	205
Lime chert	3570	3588	18
Lime	3588	3680	92
T. D.	3860		

RECEIVED  
 STATE CORPORATION COMMISSION  
 OCT 27 1957  
 CONSERVATION DIVISION  
 Wichita, Kansas

AFFIDAVIT

STATE OF KANSAS )  
Montgomery County ) SS

Leo C. Veeder, of lawful age, being first duly sworn on oath, deposes and says:

THAT he has read the above well log covering the Sandzen #1 well located in Section 14-9S-22W. Graham County, Kansas, and that the same is true and correct. Further affiant saith not.

THE VEEDER SUPPLY AND DEVELOPMENT CO.  
By Leo C. Veeder  
Leo C. Veeder

Subscribed and sworn to before me this 15th day of July, 1957.

Charles Lamson  
Notary Public

My commission expires July 11, 1960.