


STATE OF KANSAS
STATE CORPORATION COMMISSION

Give All Information Completely
Make Required Affidavit
Mail or Deliver Report to:
Conservation Division
State Corporation Commission
212 No. Market
Wichita, Kansas

WELL PLUGGING RECORD

NORTH

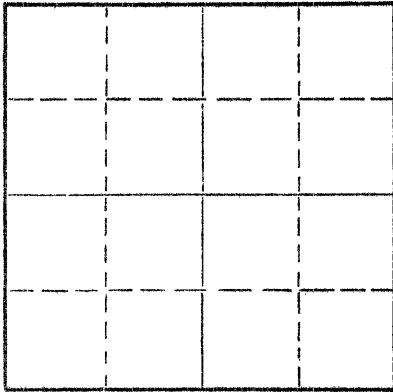

Locate well correctly on above
Section Plat

Graham County. Sec. 10 Twp. 9S Rge. (E)22 (W)
Location as "NE/CNW/SW" or footage from lines NE NE NE
Lease Owner George Ablah
Lease Name Van Loenen Well No. 1-A
Office Address Wichita, Kansas
Character of Well (completed as Oil, Gas or Dry Hole) Dry
Date well completed _____ 19____
Application for plugging filed June 10 19 69
Application for plugging approved June 11 19 69
Plugging commenced August 2 19 69
Plugging completed August 12 19 69
Reason for abandonment of well or producing formation _____

If a producing well is abandoned, date of last production _____ 19____
Was permission obtained from the Conservation Division or its agents before plugging was commenced? Yes

Name of Conservation Agent who supervised plugging of this well _____
Producing formation _____ Depth to top _____ Bottom _____ Total Depth of Well 3875 Feet
Show depth and thickness of all water, oil and gas formations.

OIL, GAS OR WATER RECORDS

CASING RECORD

FORMATION	CONTENT	FROM	TO	SIZE	PUT IN	PULLED OUT
				8-5/8"	208	None
				5-1/2"	3869	2496'

Describe in detail the manner in which the well was plugged, indicating where the mud fluid was placed and the method or methods used in introducing it into the hole. If cement or other plugs were used, state the character of same and depth placed, from _____ feet to _____ feet for each plug set.

Plug @ 3475'
Rock 3475-3465'
5 sacks cement @ 3465'
Shot pipe @ 3120, 3018, 3927, 2815, 2734, 2600 & 2496'
Pulled 2496' of 5 1/2" casing
Pumped 5 sks hulls, 17 sks gel and 100 sks cement 925-600'
Pumped 9 sks mud & 20 sks cement 240-180'
Pumped 4 sks mud & 10 sks cement 30' -surface
Plugging complete

RECEIVED
STATE CORPORATION COMMISSION
AUG 26 1969
CONSERVATION DIVISION
Wichita, Kansas

(If additional description is necessary, use BACK of this sheet)

Name of Plugging Contractor Braden-Deem, Inc.
Address 210 One Twenty Bldg., Wichita, Kansas 67202

STATE OF Kansas COUNTY OF Sedgwick, ss.
Doy C. Deem (employee of owner) or (owner or operator) of the above-described well, being first duly sworn on oath, says: That I have knowledge of the facts, statements, and matters herein contained and the log of the above-described well as filed and that the same are true and correct. So help me God.

(Signature) [Signature]
210 One Twenty Bldg., Wichita, Kansas
(Address)

SUBSCRIBED AND SWORN TO before me this 25 day of August, 19 69

My commission expires March 21, 1970

[Signature] Notary Public.

KANSAS GEOLOGICAL SOCIETY
 KANSAS WELL LOG BUREAU - KANSAS WELL SAMPLE BUREAU
 KANSAS GEOLOGICAL SOCIETY BUILDING
 508 EAST MURDOCK - WICHITA, KANSAS

REC'D JUN 6 1969

COMPANY **George Ablah**

SEC. 10 T. 9S R. 22W

FARM **Van Loenen** NO. **1A**

LOC. NE NE NE

TOTAL DEPTH **3,875'**

COUNTY **Graham**


COMM. **April 1, 1969**

COMP. **April 11, 1969**

SHOT OR TREATED

CONTRACTOR **H-30, INC.**

ISSUED

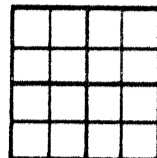

CASING

20	10				
15		8-5/8"	208'	cemented w/150 sx cement	ELEVATION 2221' KB
12	6				
13		5 1/2"	3869'	cemented w/175 sx cement	PRODUCTION

FIGURES INDICATE BOTTOM OF FORMATIONS

ELECTRIC LOG TOPS

Top Soil and Clay	40		
Shale	620	Topeka	3202 - 981
Shale and sand stringers	1265	Queen Hill	3307 -1086
Sand	1485	Heobner	3422 -1201
Red Bed	1743	Toronto	3447 -1226
Anhydrite	1775	Lansing	3462 -1241
Shale	1975	Base KC	3674 -1453
Shale and Lime	2785	Marmaton	
Lime and Shale	2860	Chert	3743 -1522
Shale and Lime	3135	Conglomerate	3808 -1587
Lime and Shale	3217	Arbuckle	3849 -1628
Lime	3345	Log T.D.	3873 -1652
Lime and Shale	3420		
Shale	3424		
Lime	3753		
Lime and Chert	3787		
Shale and Cherty Lime	3835		
Lime	3875		
Rotary Total Depth	3875		

RECEIVED
 STATE CORPORATION COMMISSION
 JUN 11 1969
 CONSERVATION DIVISION
 Wichita, Kansas

I hereby certify the above and foregoing to be a true and correct log of the above described well as shown by the drilling reports.

H-30, INC.

Merle Britting

 Merle Britting

STATE OF KANSAS }
 COUNTY OF SEDGWICK } SS:

Subscribed and Sworn to before me a Notary Public in and for said county and state this 30th day of April, 1969.

Martha Hartpence

 Martha Hartpence - Notary Public

My Commission Expires:

April 21, 1971