


STATE OF KANSAS
STATE CORPORATION COMMISSION

Give All Information Completely
Make Required Affidavit
Mail or Deliver Report to:
Conservation Division
State Corporation Commission
212 No. Market
Wichita, Kansas

WELL PLUGGING RECORD

NORTH

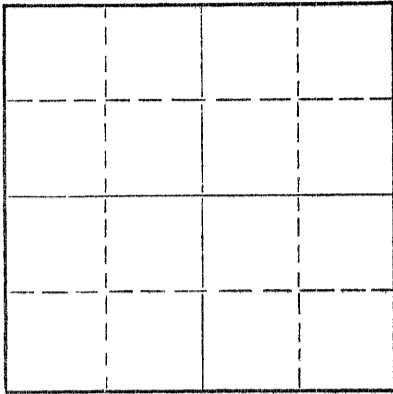

Locate well correctly on above
Section Plat

Graham County. Sec. 10 Twp. 9S Rge. (E) 22 (W)
Location as "NE/CNW/SW" or footage from lines NE SW NE
Lease Owner George J. Ablah
Lease Name Van Loenen "A" Well No. 2
Office Address 8028 Cork, Wichita, Kansas 67206
Character of Well (completed as Oil, Gas or Dry Hole) Dry Hole
Date well completed May 12 19 69
Application for plugging filed May 12 19 69
Application for plugging approved May 12 19 69
Plugging commenced May 12 19 69
Plugging completed May 12 19 69
Reason for abandonment of well or producing formation Dry hole

If a producing well is abandoned, date of last production _____ 19____
Was permission obtained from the Conservation Division or its agents before plugging was commenced? Yes

Name of Conservation Agent who supervised plugging of this well W. L. Nichols, Morland, Kansas
Producing formation _____ Depth to top _____ Bottom _____ Total Depth of Well _____ Feet
Show depth and thickness of all water, oil and gas formations.

OIL, GAS OR WATER RECORDS

CASING RECORD

FORMATION	CONTENT	FROM	TO	SIZE	PUT IN	PULLED OUT
Surface Clay & Sand		0	50			
Shale		50	209	8-5/8"	209	None

Describe in detail the manner in which the well was plugged, indicating where the mud fluid was placed and the method or methods used in introducing it into the hole. If cement or other plugs were used, state the character of same and depth placed, from _____ feet to _____ feet for each plug set.

Set plug at 950' displaced 100 sacks cement through drill pipe by Halliburton pump truck. Set plug at 215' displace 20 sacks cement though drill pipe by Halliburton pump truck. Set plug at 40' - displaced 10 sacks cement by Halliburton Pump truck.

RECEIVED
STATE CORPORATION COMMISSION
MAY 21 1969
CONSERVATION DIVISION
Wichita, Kansas

Name of Plugging Contractor H-30, INC. (If additional description is necessary, use BACK of this sheet)
Address 200 N. Main, Wichita, Kansas 67202

STATE OF KANSAS COUNTY OF SEDGWICK, ss.

Richard A. Smith (employee of owner) or (owner or operator) of the above-described well, being first duly sworn on oath, says: That I have knowledge of the facts, statements, and matters herein contained and the log of the above-described well as filed and that the same are true and correct. So help me God.

(Signature) _____
200 N. Main, Wichita, Kansas 67202
(Address)

SUBSCRIBED AND SWORN TO before me this 20th day of May, 19 69

My commission expires Notary Public

Martha Hartpence
Martha Hartpence Notary Public.


KANSAS GEOLOGICAL SOCIETY
KANSAS WELL LOG BUREAU - KANSAS WELL SAMPLE BUREAU
 KANSAS GEOLOGICAL SOCIETY BUILDING
 508 EAST MURDOCK - WICHITA, KANSAS

COMPANY **George J. Ablah**
 FARM **Van Loenen "A"** NO. **2**

SEC. **10** T. **9S** R. **22W**
 LOC. **NE SW NE**

TOTAL DEPTH **3,558**
 COMM. **5-5-69** COMP. **5-12-69**
 SHOT OR TREATED
 CONTRACTOR **H-30, INC.**
 ISSUED

COUNTY **Graham**
 KANSAS

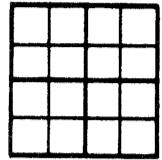

CASING
 20 10
 15 8 -5/8" 208 W/150 sx cement
 12 6
 13 5

ELEVATION **2263 GL**
2268 KB
 PRODUCTION **D & A**

FIGURES INDICATE BOTTOM OF FORMATIONS

Surface Clay & Sand	50
Shale	1370
Sand	1550
Shale & Red Bed	1811
Anhydrite	1844
Shale & Lime	2435
Lime & Shale	2630
Shale	2817
Shale & Lime	3000
Lime & Shale	3521
Lime	3558
Rotary Total Depth	3558

RECEIVED
 STATE CORPORATION COMMISSION
MAY 21 1969
 CONSERVATION DIVISION
 Wichita, Kansas

I hereby certify the above and foregoing to be a true and correct log of the above described well as shown by the drilling reports.

H-30, INC.

 Richard G. Smith

STATE OF KANSAS }
 COUNTY OF SEDGWICK } SS:

Subscribed and Sworn to before me a Notary Public in and for said county and state this 20th day of May, 1969.

Martha Hartpence
 Martha Hartpence - Notary Public

My Commission Expires:

April 21, 1971