


STATE OF KANSAS
STATE CORPORATION COMMISSION

Give All Information Completely
Make Required Affidavit
Mail or Deliver Report to:
Conservation Division
State Corporation Commission
800 Bittling Building
Wichita, Kansas

WELL PLUGGING RECORD

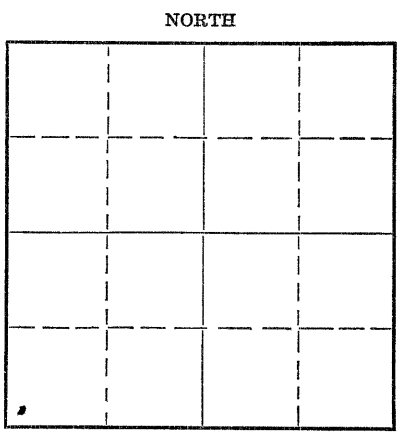

Locate well correctly on above
Section Plat

Graham County. Sec 10 Twp 98 Rge 22 (E) W (W)
Location as "NE/CNW 1/4 SW 1/4" or footage from lines _____
Lease Owner Bill E. Hay
Lease Name Van Loenen Well No. 1
Office Address Box 194, Great Bend, Kansas
Character of Well (completed as Oil, Gas or Dry Hole) dry hole
Date well completed January 11 1953
Application for plugging filed January 11 1953
Application for plugging approved January 11 1953
Plugging commenced January 11 1953
Plugging completed January 11 1953
Reason for abandonment of well or producing formation
dry hole

If a producing well is abandoned, date of last production _____ 19____
Was permission obtained from the Conservation Division or its agents before plugging was commenced? yes
Name of Conservation Agent who supervised plugging of this well Elden Petty
Producing formation _____ Depth to top _____ Bottom _____ Total Depth of Well 3921 Feet
Show depth and thickness of all water, oil and gas formations.

OIL, GAS OR WATER RECORDS

CASING RECORD

| Formation | Content | From | To | Size | Put In | Pulled Out |
|--------------|---------|------|----|--------|--------|------------|
| surface pipe | | | | 8 5/8" | 167 | none |
| | | | | | | |
| | | | | | | |
| | | | | | | |
| | | | | | | |
| | | | | | | |
| | | | | | | |
| | | | | | | |

Describe in detail the manner in which the well was plugged, indicating where the mud fluid was placed and the method or methods used in introducing it into the hole. If cement or other plugs were used, state the character of same and depth placed, from _____ feet to _____ feet for each plug set.

Filled hole to 165' with mud. Pumped 1/2 sack hulls. Set bottom plug. Dumped 20 sacks cement. Filled to 35' with mud. Set top plug. Dumped 1/2 sack hulls and 10 sacks of cement to bottom of cellar.

RECEIVED
STATE CORPORATION COMMISSION
1-24-53
JAN 24 1953
CONSERVATION DIVISION
Wichita, Kansas

(If additional description is necessary, use BACK of this sheet)
Name of Plugging Contractor Bill Hay Drilling Company
Address 371 West 3rd St. Hoisington, Kansas

STATE OF Kansas, COUNTY OF Barton, ss.
Virgil E. Belford, Jr. (employee of owner) or (owner or operator) of the above-described well, being first duly sworn on oath, says: That I have knowledge of the facts, statements, and matters herein contained and the log of the above-described well as filed and that the same are true and correct. So help me God.

(Signature) Virgil E. Belford, Jr.
Box 194, Great Bend, Kansas
(Address)

SUBSCRIBED AND SWORN TO before me this 27th day of August, 1953

My commission expires 5-9-55 _____ Notary Public.

PLUGGING
FILE SEC-1079-229
BOOK PAGE 72 LINE 28

WELL LOG

Van Loenen #1
SE SE SE 1-9S-22W
Graham County, Kansas

| | | | |
|-------------|---|-----------|------|
| 0 - 167 | Sand and Shells | | |
| 167 - 515 | Shale and Shells | | |
| 515 - 1225 | Shale, Shells and Sand | | |
| 1225 - 1290 | Shale and Shells | | |
| 1290 - 1520 | Sand | | |
| 1520 - 1720 | Shale and Red Bed | | |
| 1720 - 1790 | Shale and Pyrite | | |
| 1790 - 1835 | Anhydrite | | |
| 1835 - 2005 | Shale and Shells | Anhydrite | 1790 |
| 2005 - 2220 | Shale and Shells | Arbuckle | 3876 |
| 2220 - 2435 | Shale, Sand and Shells Total Depth 3921 | | |
| 2435 - 2480 | Shale | | |
| 2480 - 2570 | Lime and Shale | | |
| 2570 - 2695 | Shale and Lime | | |
| 2695 - 2820 | Shale and Shells | | |
| 2820 - 2940 | Shale and Lime | | |
| 2940 - 3075 | Shale and Lime | | |
| 3075 - 3160 | Shale and Broken Lime | | |
| 3160 - 3410 | Lime and Shale | | |
| 3410 - 3480 | Lime and Shale | | |
| 3480 - 3558 | Lime | | |
| 3558 - 3660 | Lime | | |
| 3660 - 3740 | Lime | | |
| 3740 - 3780 | Lime and Shale | | |
| 3780 - 3860 | Lime and Shale | | |
| 3860 - 3876 | Lime and Shale | | |
| 3876 - 3898 | Arbuckle | | |
| 3898 - 3921 | Lime | | |
| 3921 | Total Depth | | |

RECEIVED
JAN 2 1953
GEOLOGICAL DIVISION
Topeka, Kansas

STATE OF KANSAS)
COUNTY OF BARTON) ss

Virgil E. Belford, Jr., Employee of owner of the above described well being first dully sworn on oath, says: that I have knowledge of the facts, statements, and matters herein contained and the log of the above-described well as filed and that the same are true and correct to the best of my knowledge and belief.

PLUGGING
FILE SEC 1079 R 2224
BOOK PAGE 22 LINE 28

Virgil E. Belford Jr.
Box 194, GREAT Bend, KANSAS

Subscribed and Sworn to before me this 21st day of JANUARY, 1953

My Commission Expires 5-9-55

Alvin D. Bous
Notary Public