


WELL PLUGGING RECORD

Give All Information Completely
Make Required Affidavit
Mail or Deliver Report to:
Conservation Division
State Corporation Commission
211 No. Broadway
Wichita, Kansas

NORTH

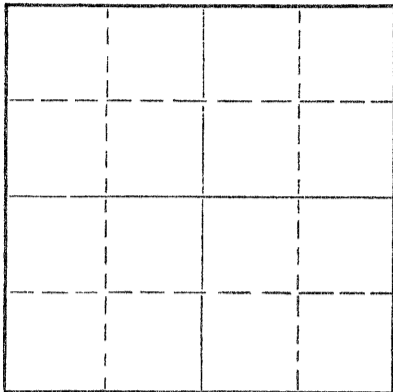

Locate well correctly on above
Section Plat

Graham County, Sec. 29 Twp. 9 Rge. 22W (E) (W)
Location as "NE/CNW/SW" or footage from lines C E/2 NW SE
Lease Owner Chief Drilling Co., Inc. & P-S Petroleum Co.
Lease Name Jeffers Well No. 1
Office Address 905 Century Plaza, Wichita, Kansas
Character of Well (completed as Oil, Gas or Dry Hole) Dry Hole
Date well completed 5/26/74 19
Application for plugging filed 5/25/74 19
Application for plugging approved 5/26/74 19
Plugging commenced 5/26/74 19
Plugging completed 5/26/74 19
Reason for abandonment of well or producing formation _____

If a producing well is abandoned, date of last production _____ 19
Was permission obtained from the Conservation Division or its agents before plugging was commenced? Yes

Name of Conservation Agent who supervised plugging of this well Bill Nichols
Producing formation _____ Depth to top _____ Bottom _____ Total Depth of Well 3860 Feet
Show depth and thickness of all water, oil and gas formations.

OIL, GAS OR WATER RECORDS

CASING RECORD

FORMATION	CONTENT	FROM	TO	SIZE	PUT IN	PULLED OUT
		0	200'	8 5/8"		

Describe in detail the manner in which the well was plugged, indicating where the mud fluid was placed and the method or methods used in introducing it into the hole. If cement or other plugs were used, state the character of same and depth placed, from _____ feet to _____ feet for each plug set.

Plugged through drill pipe @ 1050' w/ 70 sacks cement.
Plugged through drill pipe @ 215' w/20 sacks cement.
Plugged through drill pipe @ 40' w/10 sacks cement.

RECEIVED
STATE CORPORATION COMMISSION
5-29-74
MAY 29 1974
CONSERVATION DIVISION
Wichita, Kansas

(If additional description is necessary, use BACK of this sheet)
Name of Plugging Contractor Chief Drilling Co., Inc.
Address Suite 905 Century Plaza, Wichita, Kansas 67202

STATE OF KANSAS, COUNTY OF SEDGWICK, ss.
Jim Robinson (employee of owner) or ~~owner or operator~~ of the above-described well, being first duly sworn on oath, says: That I have knowledge of the facts, statements, and matters herein contained and the log of the above-described well as filed and that the same are true and correct. So help me God.

(Signature) Jim Robinson
905 Century Plaza, Wichita, Kansas 67202 (Address)

SUBSCRIBED AND SWORN TO before me this 28th day of May 19 74
My commission expires August 5, 1975
NOTARY PUBLIC
SEDGWICK CO. KANSAS

Virginia S. Fabian
Virginia S. Fabian, Notary Public.

RECEIVED
STATE CORPORATION COMMISSION

MAY 29 1974

CONSERVATION DIVISION
Wichita, Kansas

WELL LOG

CHIEF DRILLING CO., INC. &
P-S PETROLEUM CO.
Suite 905 Century Plaza
Wichita, Kansas 67202

#1 JEFFERS
C E/2 NW SE Sec. 29-9-22W
Graham County, Kansas

CONTRACTOR: Chief Drilling Co., Inc.
CASING RECORD: Set 194' of 8 5/8" w/150
sacks common quick set cement

COMMENCED: 5/19/74
COMPLETED: 5/26/74

<u>FORMATION</u>	<u>FROM</u>	<u>TO</u>	<u>ELEVATION</u>
Surface Hole	0	240	2401 Gr.
Shale	240	1225	2403 D.F.
Shale & Shells	1225	1740	2406 K.B.
Shale	1740	2199	
Shale & Lime	2199	2400	
Shale & Shells	2400	2887	
Shale & Lime	2887	3357	
Lime	3357	3860	
Total Depth	3860		

<u>FORMATION TOPS</u>			
Anhydrite	1931	+	475
Base Anhy.	1967	+	439
Heebner	3619	-	1213
Toronto	3644	-	1238
Lansing	3654	-	1248
R.T.D.	3860	-	1454

STATE OF KANSAS, COUNTY OF SEDGWICK) ss:

I hereby certify that the above is a true and correct copy of the Driller's Log of the well drilled in the C E/2 NW SE of Section 29-9-22W, Graham County, Kansas, to the best of my knowledge and belief.

CHIEF DRILLING CO., INC.

Jim Robinson, Vice President

Subscribed and sworn to before me this 28th day of May, 1974.

Virginia S. Fabian, Notary Public

