

STATE OF KANSAS
STATE CORPORATION COMMISSION

Give All Information Completely
Make Required Affidavit
Mail or Deliver Report to:
Conservation Division
State Corporation Commission
212 North Market, Insurance Bldg.
Wichita, Kansas

WELL PLUGGING RECORD

Graham County. Sec. 29 Twp. 9 Rge. 22W (E) (W)

Location as "NE/CNW/SW" or footage from lines NW SE NE

Lease Owner John O. Farmer, Inc.

Lease Name Farrell "B" Well No. #1

Office Address Box 352 Russell, Kansas 67665

Character of Well (completed as Oil, Gas or Dry Hole) Dry Hole

Date well completed 9-9-78 19

Application for plugging filed Yes 19

Application for plugging approved 19


Plugging commenced 19

Plugging completed 5:30 p.m. 9-9-78 19

Reason for abandonment of well or producing formation _____

If a producing well is abandoned, date of last production _____ 19

Was permission obtained from the Conservation Division or its agents before plugging was commenced? Yes

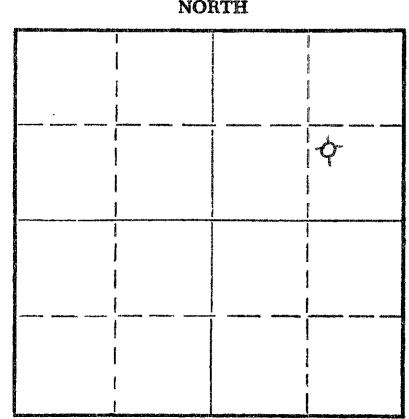

Locate well correctly on above Section Plat

Name of Conservation Agent who supervised plugging of this well Gilbert Balthazor

Producing formation _____ Depth to top _____ Bottom _____ Total Depth of Well 3880 Feet

Show depth and thickness of all water, oil and gas formations.

OIL, GAS OR WATER RECORDS

CASING RECORD

FORMATION	CONTENT	FROM	TO	SIZE	PUT IN	PULLED OUT

Describe in detail the manner in which the well was plugged, indicating where the mud fluid was placed and the method or methods used in introducing it into the hole. If cement or other plugs were used, state the character of same and depth placed, from _____ feet to _____ feet for each plug set.

- Plug #1 850' w/70 sx. Cement
- Plug #2 200' w/20 sx. Cement
- Plug #3 40' w/10 sx. Cement

RECEIVED
STATE CORPORATION COMMISSION

SEP 14 1978
9-14-78
CONSERVATION DIVISION
Wichita, Kansas

(If additional description is necessary, use BACK of this sheet)

Name of Plugging Contractor John O. Farmer, Inc.

Address Box 352 Russell, Kansas 67665

STATE OF Kansas, COUNTY OF Russell, ss.
John O. Farmer (employee of owner) or (owner or operator) of the above-described


well, being first duly sworn on oath, says: That I have knowledge of the facts, statements and matters herein contained and the log of the above-described well as filed and that the same are true and correct. So help me God.

(Signature) John O. Farmer

Box 352 Russell, Kansas 67665
(Address)

Subscribed and Sworn to before me this 12th day of September, 19 78

My commission expires February 15, 1979
Helen Carlson Notary Public.

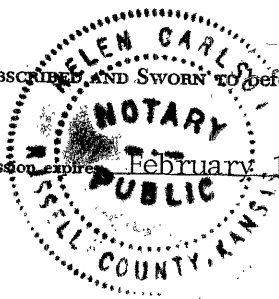


KANSAS DRILLERS LOG

S. 29 T. 9 R. 22W ^E/_W

Loc. NW SE NE

County Graham

640 Acres
N

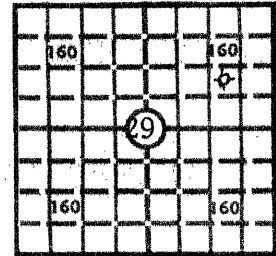

Locate well correctly

Elev.: Gr. 2403'

DF 2406' KB 2408'

API No. 15 — _____
County _____ Number _____

Operator
John O. Farmer, Inc.

Address
Box 352 Russell, Kansas 67665

Well No. #1 Lease Name Farrell "B"

Footage Location
990' feet from (NO) (S) line 990' feet from (E) (NW) line

Principal Contractor John O. Farmer, Inc. Geologist Sam Farmer

Spud Date 9-1-78 Total Depth 3880' P.B.T.D. _____

Date Completed 9-9-78 Oil Purchaser _____

CASING RECORD

Report of all strings set — surface, intermediate, production, etc.

Purpose of string	Size hole drilled	Size casing set (in O.D.)	Weight lbs/ft.	Setting depth	Type cement	Sacks	Type and percent additives
Surface	12 1/4	8-5/8	26	208'	Common	170	

LINER RECORD

PERFORATION RECORD

Top, ft.	Bottom, ft.	Sacks cement	Shots per ft.	Size & type	Depth interval

TUBING RECORD

Size	Setting depth	Packer set at

ACID, FRACTURE, SHOT, CEMENT SQUEEZE RECORD

Amount and kind of material used	Depth interval treated

RECEIVED
STATE CORPORATION COMMISSION

SEP 14 1978

CONSERVATION DIVISION
Wichita, Kansas

INITIAL PRODUCTION

Date of first production _____		Producing method (flowing, pumping, gas lift, etc.) _____					
RATE OF PRODUCTION PER 24 HOURS	Oil _____ bbls.	Gas _____ MCF	Water _____ bbls.	Gas-oil ratio _____	CFPB _____		
Disposition of gas (vented, used on lease or sold) _____			Producing interval (s) _____				

INSTRUCTIONS: As provided in KCC Rule 82-2-125, within 90 days after completion of a well, one completed copy of this Drillers Log shall be transmitted to the State Geological Survey of Kansas, 4150 Monroe Street, Wichita, Kansas 67209. Copies of this form are available from the Conservation Division, State Corporation Commission, 3830 So. Meridian (P.O. Box 17027), Wichita, Kansas 66217. Phone AC 316-522-2206. If confidential custody is desired, please note Rule 82-2-125. Drillers Logs will be on open file in the Oil and Gas Division, State Geological Survey of Kansas, Lawrence, Kansas 66044.

DESIGNATE TYPE OF COMP.: OIL, GAS, DRY HOLE, SWDW, ETC.:

Operator John O. Farmer, Inc.

Well No. #1 Lease Name Farrell "B" Dry Hole


S 29 T 9 R 22W E W

WELL LOG
 Show all important zones of porosity and contents thereof; cored intervals, and all drill-stem tests, including depth interval tested, cushion used, time tool open, flowing and shut-in pressures, and recoveries.
 SHOW GEOLOGICAL MARKERS, LOGS RUN, OR OTHER DESCRIPTIVE INFORMATION.

FORMATION DESCRIPTION, CONTENTS, ETC.	TOP	BOTTOM	NAME	DEPTH
Clay Post Rock	-0-	80	Anhydrite	1926' (+482)
Sand Streaks	80	165	Heebner	3622' (-1214)
Blue Shale	165	208	Toronto	3645' (-1237)
Shale & Sand	208	1450	Lansing	3658' (-1250)
Sand	1450	1670	TD	3880'
Red Bed	1670	1926		
Anhydrite	1926	1971		
Shale & Shells	1971	2345		
Shale & Lime	2345	3445		
Lime & Shale	3455	3705		
Lime	3705	3880		
DST #1 3681' to 3731' Open: 30-30-60-60; good blow Rec: 30' slightly oil cut watery mud 120' muddy water BHP: 576-565 FP: 54-65 65-87	DST #3 (Continued) ... BHP: 980-917 TD: 3880'			
DST #2 3805' to 3838' Open: 15-30; very weak blow Rec: 50' Muddy water FP: 21-21 BHP: 371				
DST #3 3830' to 3880' Open: 30-30-60-45; weak blow Rec: 90' muddy water FP: 43-43 61-76				

USE ADDITIONAL SHEETS, IF NECESSARY, TO COMPLETE WELL RECORD.

Date Received _____

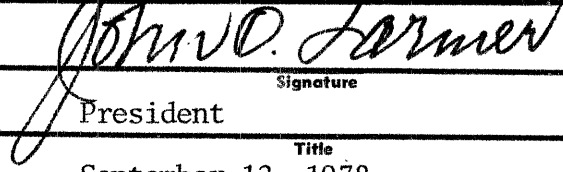
 Signature
 President
 Title
 September 12, 1978
 Date