

STATE OF KANSAS
STATE CORPORATION COMMISSION

WELL PLUGGING RECORD

Give All Information Completely
Make Required Affidavit
Mail or Deliver Report to
Conservation Division
State Corporation Comm.
245 North Water
Wichita, KS 67202

Graham County. Sec. 29 Twp. 9S Rge. 22W E/W
Location as "NE/CNW $\frac{1}{4}$ SW $\frac{1}{4}$ " or footage from lines
NW NE


Lease Owner Moble C. Hoover
Lease Name John R. Farrett #1 Well No. #1
Office Address NBC Bldg. Suite 302 Eldorado, Arkansas
Character of Well (Completed as Oil, Gas or Dry Hole)
Dry Hole

Date Well completed December 17 19 76
Application for plugging filed (verbally) 12-17 19 76
Application for plugging approved (verbally) 12-17- 19 76
Plugging commenced 12-17-76 19
Plugging completed 12-17-76 19

Reason for abandonment of well or producing formation
No commercial quantity of oil or gas encountered.
If a producing well is abandoned, date of last production
None 19

Was permission obtained from the Conservation Division or
its agents before plugging was commenced? Yes

Name of Conservation Agent who supervised plugging of this well Gilbert Balthazor
Producing formation _____ Depth to top _____ Bottom _____ Total Depth of Well _____
Show depth and thickness of all water, oil and gas formations.

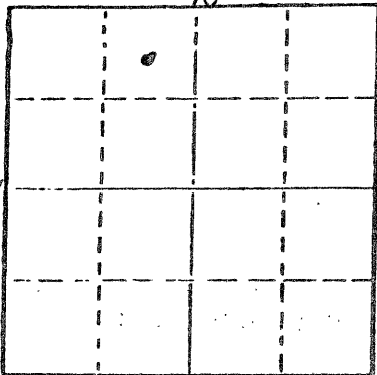

OIL, GAS OR WATER RECORDS

CASING RECORD

FORMATION	CONTENT	FROM	TO	SIZE	PUT IN	PULLED OUT
				8 5/8	243.21	

Describe in detail the manner in which the well was plugged, indicating where the mud fluid was placed and the method or methods used in introducing it into the hold. If cement or other plugs were used, state the character of same and depth placed, from _____ feet to _____ feet for each plug set.

- 1st plug set @ 950' with 70 sacks
- 2nd plug at 250' with 20 sacks
- 3rd plug at 40' with 10 sacks

Plug was down @ 1:30 a.m. 12-17-76
State Plugger: Gilbert Balthazor

RECEIVED
STATE CORPORATION COMMISSION
DEC 23 1976
12-23-76
CONSERVATION DIVISION
Wichita, Kansas

(If additional description is necessary, use BACK of this sheet)

Name of Plugging Contractor _____

STATE OF Kansas COUNTY OF Sedgwick ss.

Jack L. Partridge (employee of owner) or (owner or operator) of the above-described well, being first duly sworn on oath, says: That I have knowledge of the facts, statements, and matters herein contained and the log of the above-described well as filed and that the same are true and correct. So help me God.

(Signature) _____

801 Union Center, Wichita, Kansas 67202
(Address)

Subscribed and Sworn to before me this 22 day of December, 19 76

Kathy Goertz *Kathy S. Goertz*
Notary Public.

My commission expires _____



CONTRACTOR'S WELL LOG

OPERATOR: Moble C. Hoover
 CONTRACTOR: Abercrombie Drilling, Inc.
 WELL NAME: JOHN R. FARRELL #1
 LOCATION: NW NE
 Section 20-9S-22W
 Graham County, Kansas
 SPUD DATE: 12-6-76
 COMPLETION DATE: 12-17-6

0	195	Sand
195	255	Shale
255	695	Sand & Shale
695	2180	Shale
2180	2752	Shale & shells
2752	3012	Shale
3012	3235	Lime & Shale
3235	3553	Shale & Lime
3553	3692	Lime
3692	3710	Shale & Lime
3710	3725	Lime & Shale
3725	3729	Shale & Lime
3729	3752	Lime
3752	3850	Shale & lime
3850	3996	Lime
3996	4070	Lime & Chert
	4070	Rotary Total Depth

Spud hole at 5:15 p.m. 12-6-76, Drilled 250' of 12 1/4" hole, Ran 6 jts. of used 8 5/8" -28 # casing. (Tally 243.21) Set at 251.21'. Cemented with 175 sx. of Allied Cement, 2% gel, 3% Ca. Cl. Plug was down at 12:00 p.m. 12-06-76. Preparing to drill out from under surface at 8:30 a.m. 12-07-76.

T.D. 4070', D&A Set 1st plug at 950' with 70 sx., 2nd plug at 250' with 20 sx. and 3rd plug at 40' with 10' sx.-50/50 posmix, 6% gel. Plug was down at 1:30 a.m. 12-17-76. State Plugger--Gilbert Balthazor.

SAMPLE TOPS:

Anhydrite 1925' (+485)
 B/Anhydrite 1964' (+446)

RECEIVED
 STATE CORPORATION COMMISSION
 DEC 23 1976

STATE OF KANSAS)
 COUNTY OF SEDGWICK)

CONSERVATION DIVISION
 Wichita, Kansas

Jack L. Partridge, Executive Vice President of Abercrombie Drilling, Inc., does hereby state that the above and foregoing is a true and correct copy of the JOHN R. FARRELL #1, NW NE Section 20-9S-22W, Graham County, Kansas.

ABERCROMBIE DRILLING, INC.

By: Jack L. Partridge
 Jack L. Partridge, Exec. V.P.

Subscribed and sworn to before me, a Notary Public, in and for the aforesaid county and state as of this 22 day of December, 1976.

Kathy S. Goertz
 Kathy Goertz, Notary Public

