

STATE OF KANSAS
STATE CORPORATION COMMISSION

Form CP-4


WELL PLUGGING RECORD

Give All Information Completely
Make Required Affidavit
Mail or Deliver Report to:
Conservation Division
State Corporation Commission
211 No. Broadway
Wichita, Kansas

GRAHAM County, Sec. 29 Twp. 9 Rge. (X) 22 (W)

Location as "NE/CNW/SW" or footage from lines C NE NW
Lease Owner PETROLEUM, INC.
Lease Name MANAUGH "E" Well No. 1
Office Address ROUTE #2, GREAT BEND, KANSAS
Character of Well (completed as Oil, Gas or Dry Hole) DRY HOLE
Date well completed FEBRUARY 27 19 65
Application for plugging filed FEBRUARY 27 19 65
Application for plugging approved FEBRUARY 27 19 65
Plugging commenced FEBRUARY 27 19 65
Plugging completed FEBRUARY 27 19 65
Reason for abandonment of well or producing formation NO PRODUCIBLE ZONES

NORTH

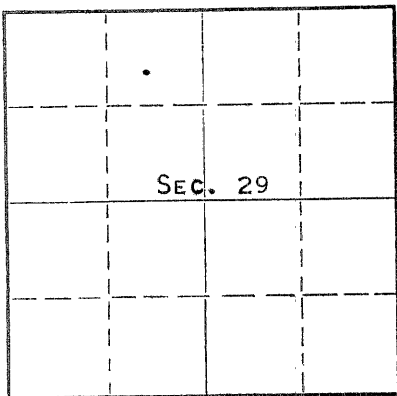

Locate well correctly on above
Section Plat

If a producing well is abandoned, date of last production - 19
Was permission obtained from the Conservation Division or its agents before plugging was commenced? YES

Name of Conservation Agent who supervised plugging of this well W. L. NICHOLS, MORLAND, KANSAS
Producing formation _____ Depth to top _____ Bottom _____ Total Depth of Well 3881 Feet
Show depth and thickness of all water, oil and gas formations.

OIL, GAS OR WATER RECORDS

CASING RECORD

FORMATION	CONTENT	FROM	TO	SIZE	PUT IN	PULLED OUT
				8-5/8	214	NONE

Describe in detail the manner in which the well was plugged, indicating where the mud fluid was placed and the method or methods used in introducing it into the hole. If cement or other plugs were used, state the character of same and depth placed, from _____ feet to _____ feet for each plug set.

MUDDED UP WITH HEAVY MUD THROUGH DRILL PIPE TO 540', FOLLOWED BY A WOODEN PLUG AND 20 SACKS CEMENT, MUDDED UP WITH HEAVY MUD TO 210', FOLLOWED BY WOODEN PLUG AND 20 SACKS CEMENT. MUDDED UP WITH HEAVY MUD TO 40', FOLLOWED BY WOODEN PLUG AND 10 SACKS CEMENT TO BASE OF WELL CELLAR.

RECEIVED
STATE CORPORATION COMMISSION

MAR 8 1965
3-8-65
CONSERVATION DIVISION
Wichita, Kansas

(If additional description is necessary, use BACK of this sheet)

Name of Plugging Contractor GARVEY DRILLING COMPANY
Address ROUTE #2, GREAT BEND, KANSAS

STATE OF KANSAS, COUNTY OF BARTON, ss.
MONTE CHADD (employee of owner) or (owner or operator) of the above-described well, being first duly sworn on oath, says: That I have knowledge of the facts, statements, and matters herein contained and the log of the above-described well as filed and that the same are true and correct. So help me God. MONTE CHADD, DIST. PROD. SUPT.

(Signature) *Monte Chadd*
ROUTE #2, GREAT BEND, KANSAS
(Address)

SUBSCRIBED AND SWORN to before me this 4 day of MARCH, 19 65

Donna P. Freeman
Notary Public.

My commission expires OCTOBER 19, 1968

WELL LOG

COMPANY Petroleum, Inc.

SEC. 29 T. 9S R. 22W

FARM Manaugh

NO. E-1

LOC. App NE NW


TOTAL DEPTH 3881'

COUNTY Graham

COMM. 2-18-65

COMP. 2-27-65

CONTRACTOR

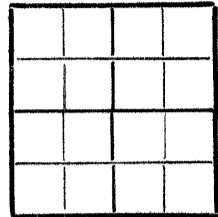

CASING 8 5/8" @ 214' w/210 sx

ELEVATION

PRODUCTION D & A

FIGURES INDICATE BOTTOM OF FORMATIONS

100' Clay and Sand
216' Shale
1575' Shale and Sand Streaks
1785' Shells and Shale
1917' Shale and Shells
1955' Anhydrite
2065' Red Bed and Shells
2645' Shale and Lime
2755' Lime
2955' Lime and Shale
3060' Shale and Lime
3630' Lime and Shale
3754' Lime
3802' Lime and Shale
3881' Lime
3881' RTD

RECEIVED
STATE CORPORATION COMMISSION
MAR 8 1965
CONSERVATION DIVISION
Wichita, Kansas

State of Kansas }
County of Barton } ss

I, Sam N. Stephens of Garvey Drilling Company
upon oath state the above and foregoing is a true and correct copy of the log of the Manaugh E-1 well.

Sam N. Stephens

Subscribed and sworn to before me this 3rd day of March 19 65

My Commission Expires: October 19, 1968

Donie A. Stearns
NOTARY PUBLIC