

15-065-00486-00-00


STATE OF KANSAS
STATE CORPORATION COMMISSION

WELL PLUGGING RECORD

Give All Information Completely
Make Required Affidavit
Mail or Deliver Report to:
Conservation Division
State Corporation Commission
211 No. Broadway
Wichita, Kansas

Graham County, Sec. 29 Twp. 9S Rge. (X) 22 (W)

Location as "NE/CNW $\frac{1}{4}$ SW $\frac{1}{4}$ " or footage from lines NW SE NW
Lease Owner Iron Drilling Co
Lease Name Josephine Manaugh Well No. 1
Office Address 1206 Philtower Bldg., Tulsa, Okla.
Character of Well (completed as Oil, Gas or Dry Hole) Dry Hole
Date well completed 9-16-58 19
Application for plugging filed " 19
Application for plugging approved " 19
Plugging commenced " 19
Plugging completed " 19
Reason for abandonment of well or producing formation Dry Hole

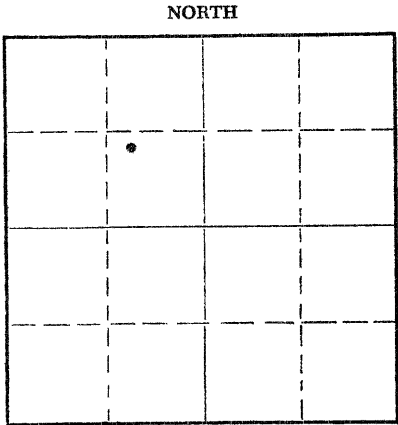

Locate well correctly on above Section Plat

If a producing well is abandoned, date of last production None 19
Was permission obtained from the Conservation Division or its agents before plugging was commenced? Yes

Name of Conservation Agent who supervised plugging of this well A. D. Fabricius
Producing formation None Depth to top Bottom Total Depth of Well 4052 Feet
Show depth and thickness of all water, oil and gas formations.

OIL, GAS OR WATER RECORDS

CASING RECORD

FORMATION	THICKNESS	FROM	TO	SIZE	PUT IN	PULLED OUT
Heebner	3601	3601		8-5/8	213	None
Toronto	3623	3623				
Lansing	3638	3638				
Base of Kansas City			3864			
Marmaton		3884				
Conglomerate		3963				
Solid Arbuckle		4049				

Describe in detail the manner in which the well was plugged, indicating where the mud fluid was placed and the method or methods used in introducing it into the hole. If cement or other plugs were used, state the character of same and depth placed, from _____ feet to _____ feet for each plug set.

Filled Hole with Heavy Mud to 600 feet.

Set Plug at 600' using 20 sacks of cement.

Filled Hole w/ heavy Mud to 210'. Set wood plug at 210' & cemented w/ 20 sacks of cement & 1/4 sack of Hulls

Filled hole with mud to 40'. Set wood plug at 40' & cemented with 10 sacks of cement & 1/4 sack of Hulls.

(If additional description is necessary, use BACK of this sheet)

Name of Plugging Contractor Iron Drilling Company
Address Tulsa, Okla.

STATE OF Oklahoma, COUNTY OF Tulsa, ss.
J. L. Stackpole (employee of owner) or (owner or operator) of the above-described well, being first duly sworn on oath, says: That I have knowledge of the facts, statements, and matters herein contained and the log of the above-described well as filed and that the same are true and correct. So help me God.

(Signature) Iron Drilling Company
J. L. Stackpole
1206 Philtower Bldg., Tulsa, Okla.
(Address)

SUBSCRIBED AND SWORN TO before me this 1st day of October

My commission expires Feb. 28, 1960

Notary Public
J. Mitchell
1958
KANSAS STATE CORPORATION COMMISSION

PLUGGING
FILE SEC 29 T 9 R 22 W
BOOK PAGE 131 LINE 42

DRILLING RECORD

Josephine Manaugh No. 1
NW SE NW Sec. 29-9S-22W
Graham County, Kansas

213' - 8-5/8" OD Casing
cemented w/

No Oil String - Dry Hole

Drilling Commenced 9/5/58
Drilling Completed 9/16/58

WELL LOG

Surface	0 - 70
Sand	70 - 100
Shale	100 - 223
Shale & Shells	223 - 1200
Sand & Shale	1200 - 1390
Sand	1390 - 1640
Red Bed	1640 - 1905
Anhydrite	1905 - 1940
Shale & Shells	1940 - 2190
Shale & Lime	2190 - 2480
Ft. Riley	2480 - 2590
Lime & Shale	2590 - 2690
Shale	2690 - 2715
Lime & Shale	2715 - 3005
Lime	3005 - 3075
Shale	3075 - 3115
Shale & Lime	3115 - 3245
Lime	3245 - 3295
Shale & Lime	3295 - 3380
Lime	3380 - 3495
Lime & Shale	3495 - 3585
Lime	3585 - 3878
Lime & Shale	3878 - 3920
Shaly Conglomerate	3870 - 3920
Conglomerate & Marmaton	3920 - 3968
Conglomerate	3968 - 4040
Arbuckle	4040 - 4052 TD

C E R T I F I C A T I O N

State of Oklahoma, County of Tulsa, SS

I, J. L. Stackpole, Employee of Iron Drilling Company, certify that the accompanying is a true and correct log of the above described well.

J. L. Stackpole

Subscribed to and Sworn before me this 1st day of October, 1958.

B. Michal
Notary Public

My Commission expires Feb. 28, 1960

RECEIVED
STATE COMMISSION
OCT 21 1958
CONSERVATION DIVISION
Tulsa, Kansas

PLUGGING
FILE SEC 29 T 9 R 22W
BOOK PAGE 131 LINE 42