


15-163-00854-00-00

STATE OF KANSAS  
STATE CORPORATION COMMISSION

Give All Information Completely  
Make Required Affidavit  
Mail or Deliver Report to:  
Conservation Division  
State Corporation Commission  
800 Bitting Building  
Wichita, Kansas

WELL PLUGGING RECORD

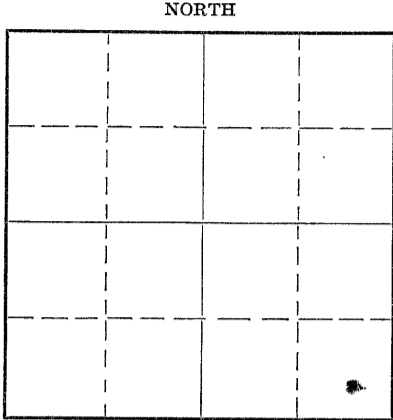

Locate well correctly on above  
Section Plat

Rooks County. Sec. 31 Twp. 8s Rge. 17w (E) (W)  
Location as "NE/CNW $\frac{1}{4}$ SW $\frac{1}{4}$ " or footage from lines SE $\frac{1}{4}$  SE SE 330S 330E  
Lease Owner Grant Oil Co.  
Lease Name Dopita A Well No. 3  
Office Address 518 WKH Bldg., Wichita, Kansas.  
Character of Well (completed as Oil, Gas or Dry Hole) Dry hole  
Date well completed July 12 1955  
Application for plugging filed July 12 1955  
Application for plugging approved July 12 1955  
Plugging commenced July 12 1955  
Plugging completed July 12 1955  
Reason for abandonment of well or producing formation dry

If a producing well is abandoned, date of last production never produced 19  
Was permission obtained from the Conservation Division or its agents before plugging was commenced? yes

Name of Conservation Agent who supervised plugging of this well Eldon Petty  
Producing formation Arbuckle Depth to top 3389' Bottom 3410' Total Depth of Well 3410 Feet  
Show depth and thickness of all water, oil and gas formations.

OIL, GAS OR WATER RECORDS

CASING RECORD

Formation	Content	From	To	Size	Put In	Pulled Out
surface	water	0	152	10 3/4	152	none

Describe in detail the manner in which the well was plugged, indicating where the mud fluid was placed and the method or methods used in introducing it into the hole. If cement or other plugs were used, state the character of same and depth placed, from \_\_\_\_\_ feet to \_\_\_\_\_ feet for each plug set.

Halliburton plug at 145' . $\frac{1}{2}$ sack of hulls, 20 sacks of cement mix.  
Haliburton plug at 35' . $\frac{1}{2}$ sack of hulls, 10 sacks of cement mix.

(If additional description is necessary, use BACK of this sheet)


Correspondence regarding this well should be addressed to Grant Oil Co.  
Address 518 W.K.H. Bldg., Wichita, Kansas

STATE OF Kansas, COUNTY OF Sedgewick, ss. 7/21/55  
Paul Pfeiffer (employee of owner) or (owner or operator) of the above-described well,  
being first duly sworn on oath, says: That I have knowledge of the facts, statements, and matters herein contained and the log of the above-described well as filed and that the same are true and correct. So help me God.

(Signature) Paul Pfeiffer  
(Address)

SUBSCRIBED AND SWORN to before me this 20th day of July, 1955

My commission expires Feb. 29, 1956  
Helen Schult Notary Public

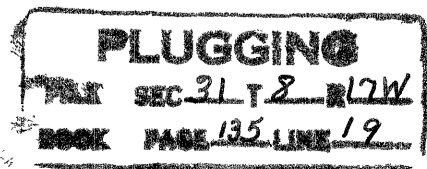

DOPIA #3

SE/r SE/4 SE/4 of Section 31-8S-17W, Rooks County, Kansas

Rigged up Rotary Tools 7/2/55

Ran 5 Jts. (152') 10 3/4" 32.75# New  
Casing set at 152'. Cemented with 125  
sacks bulk cement, 2 cc

Tore down Rotary Tools 7/12/55

<u>FORMATION</u>	<u>FROM</u>	<u>TO</u>
Shale, sand & shells	0'	162'
Shale, sand & redbed	162	723
Shale	723	800
Dakota Sand	800	980
Shale, shells & anhydrite	980	1283
Shale & shells	1283	1520
Shale, shells & lime	1520	1818
Shale & shells	1818	1900
Shale w/lime streaks	1900	1984
Shale & shells	1984	2065
Lime & shale	2065	2300
Lime w/shale streaks	2300	2431
Lime & shale	2431	2616
Broken lime & shale	2616	2816
Shale & lime	2816	3160
Lime	3160	3258
Lime & shale	3258	3295
Lime	3295	3341
Shale & lime	3341	3389
Arbuckle Lime	3389	3410 TD

I, W. A. Grant, do hereby certify that the foregoing log is true and correct,  
to the best of my knowledge and belief.



Subscribed and sworn to before me this 15th day of July, 1955.



Notary Public

My commission expires: Feb. 29, 1956.

7/21/55

**PLUGGING**  
FILE SEC 31 T 8 R 17W  
BOOK PAGE 135 LINE 19