


WELL PLUGGING RECORD

Give All Information Completely
Make Required Affidavit
Mail or Deliver Report to:
Conservation Division
State Corporation Commission
800 Bitting Building
Wichita, Kansas

Graham County. Sec. 13 Twp. 10S Rge. 21W (X) W (W)
Location as "NE/CNW/SW" or footage from lines NE/4 NW/4 NW/4
Lease Owner D. G. Hansen
Lease Name Bass "A" Well No. 5
Office Address Logan, Kansas
Character of Well (completed as Oil, Gas or Dry Hole) Dry Hole
Date well completed May 25, 1955
Application for plugging filed May 25, 1955
Application for plugging approved May 25, 1955
Plugging commenced May 25, 1955
Plugging completed May 25, 1955
Reason for abandonment of well or producing formation Too low structurally

NORTH

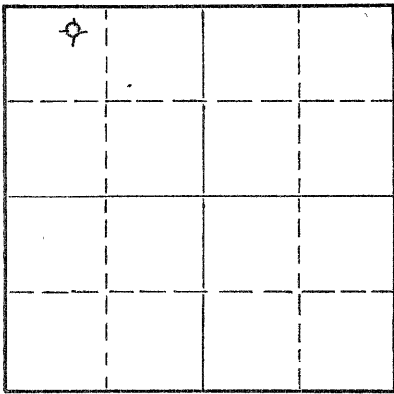

Locate well correctly on above
Section Plat

If a producing well is abandoned, date of last production _____ 19____
Was permission obtained from the Conservation Division or its agents before plugging was commenced? Yes

Name of Conservation Agent who supervised plugging of this well Eldon Petty
Producing formation _____ Depth to top _____ Bottom _____ Total Depth of Well _____ Feet
Show depth and thickness of all water, oil and gas formations.

OIL, GAS OR WATER RECORDS

CASING RECORD

FORMATION	CONTENT	FROM	TO	SIZE	PUT IN	PULLED OUT
				8-5/8"	168.73'	none

Describe in detail the manner in which the well was plugged, indicating where the mud fluid was placed and the method or methods used in introducing it into the hole. If cement or other plugs were used, state the character of same and depth placed, from _____ feet to _____ feet for each plug set.

Filled hole with heavy mud to 165'. Set plug.
Put in 1/2 sack hulls and 15 sacks cement, filled
up to 40'. Set plug. Filled to top with 1/2
sack hulls and 10 sacks cement.

(If additional description is necessary, use BACK of this sheet)

Name of Plugging Contractor C-G DRILLING CO.
Address 107 Rule Bldg., Wichita, Kansas


STATE OF KANSAS, COUNTY OF SEDGWICK, ss.
Jay H. Galloway (employee of owner) or (~~owner or operator~~) of the above-described well, being first duly sworn on oath, says: That I have knowledge of the facts, statements, and matters herein contained and the log of the above-described well as filed and that the same are true and correct. So help me God.

(Signature) Jay H. Galloway
107 Rule Bldg., Wichita, Kansas
(Address)

SUBSCRIBED AND SWORN TO before me this 25th day of May, 1955

My commission expires June 25, 1955

Wicky Fritz
Notary Public.

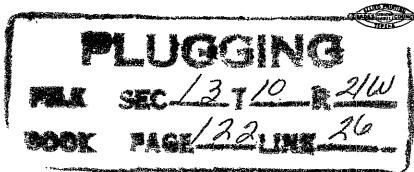

05-30-1955

15-065-02370-00-00

CONTRACTOR'S WELL LOG

OPERATOR D. G. HANSEN WELL NAME BASS "A" #5

LOCATION NE/ NW/ NW/ Sec. 13-10S-21W.

POOL NAME _____ COUNTY GRAHAM STATE KANSAS

COMMENCEMENT DATE MAY 16, 1955 COMPLETION DATE MAY 25, 1955

LOG OF WELL

Elevation 2281' R.B.

All measurements from the top of rotary bushing.

FROM	TO	FORMATION	DEVIATION FROM VERTICAL	REMARKS:
0	168	Shale-Sand		
168	800	Shale		
800	890	Sand		
890	1180	Sand-Shale		
1180	1240	Sandy Shale		
1240	1495	Sand		
1495	1758	Red Bed	0° - 1500'	
1758	1798	Anhydrite		
1798	1830	Shale-Shells		
1830	2260	Shale-Shells	0° - 2000'	
2260	2395	Lime-Shale		
2395	2510	Lime-Shale	0° - 2500'	
2510	2630	Lime-Shale		
2630	2800	Lime-Shale		
2800	2940	Lime-Shale		
2940	3025	Lime-Shale	0° - 3000'	
3025	3200	Lime-Shale		
3200	3315	Lime-Shale		
3315	3400	Lime-Shale		
3400	3445	Lime-Shale		
3445	3515	Lime-Shale	0° - 3500'	
3515	3575	Lime-Shale		
3575	3619	Lime-Shale		
3619	3665	Lime-Shale		
3665	3720	Lime-Shale		
3720	3768	Lime-Shale	0° - 3750'	
3768	3828	Lime-Shale		
3828	3852	Cherty Lime-Shale		
3852	3856	Lime-Shale		DST 3850-56
3856	3883	Lime-Shale		

CASING LEFT IN HOLE AFTER COMPLETION

Set 8 jts. (168.73') 8-5/8" OD Surface Casing.

STATE OF KANSAS, COUNTY OF SEDGWICK) ss.

The undersigned certifies that to the best of his knowledge and belief, the above facts are true and correct.

C-G DRILLING CO

By Jay H. Galloway
Jay H. Galloway

Subscribed and sworn to before me this 25th day of May, 1955.

My commission expires: June 25, 1955

Wicki Lutz
Notary Public

PLUGGING
WELL SEC 13-10 R 21W
PAGE 122 LINE 26

05-30-1955