


STATE OF KANSAS
STATE CORPORATION COMMISSION

Give All Information Completely
Make Required Affidavit
Mail or Deliver Report to:
Conservation Division
State Corporation Commission
211 No. Broadway
Wichita, Kansas

15-065-19162-00-00

WELL PLUGGING RECORD

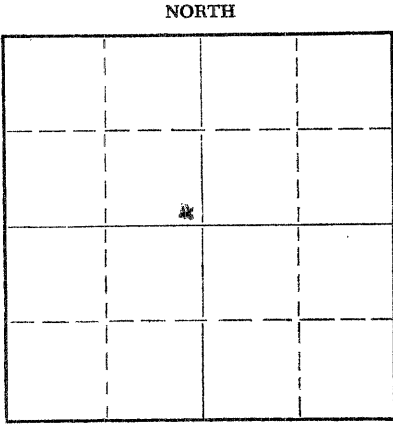

Locate well correctly on above
Section Plat

Graham County. Sec. 13 Twp. 10 Rge. 21 (E) W (W)
Location as "NE/CNW/SW" or footage from lines SE SE NW
Lease Owner D.G. Hansen
Lease Name Bass - A Well No. 1
Office Address Logan, Kans.
Character of Well (completed as Oil, Gas or Dry Hole) Oil
Date well completed _____ 19____
Application for plugging filed Sept. 19 19 58
Application for plugging approved Sept. 21 19 58
Plugging commenced Sept. 26 19 58
Plugging completed Oct. 1 19 58
Reason for abandonment of well or producing formation Depleted.

If a producing well is abandoned, date of last production _____ 19____
Was permission obtained from the Conservation Division or its agents before plugging was commenced? Yes

Name of Conservation Agent who supervised plugging of this well A.D. Fabricious
Producing formation _____ Depth to top _____ Bottom _____ Total Depth of Well 3850 Feet
Show depth and thickness of all water, oil and gas formations.

OIL, GAS OR WATER RECORDS

CASING RECORD

FORMATION	CONTENT	FROM	TO	SIZE	PUT IN	PULLED OUT

Describe in detail the manner in which the well was plugged, indicating where the mud fluid was placed and the method or methods used in introducing it into the hole. If cement or other plugs were used, state the character of same and depth placed, from _____ feet to _____ feet for each plug set.

Plug back with sand to 3835' mixed and dumped 4 sx cem., pulled 5 1/2 casing, filled hole with mud to 165' set 10' rock bridge mixed and dumped 25 sx cem filled hole with to 40' set 10' rock bridge, Mixed and put in 10 sx cem fill to base of cellar.

(If additional description is necessary, use BACK of this sheet)
Name of Plugging Contractor Southwest Casing Pulling Co., Inc.
Address Great Bend, Kans

STATE OF KANSAS, COUNTY OF BARTON, ss.

_____, (employee of owner) or (owner or operator) of the above-described well, being first duly sworn on oath, says: That I have knowledge of the facts, statements, and matters herein contained and the log of the above-described well as filed and that the same are true and correct. So help me God.

(Signature) Warren H. Warner

SUBSCRIBED AND SWORN TO before me this 11th day of October, 19 58

My commission expires 2/27/60

(Address) Marjorie R. Juma
Notary Public.

PLUGGING
FILE SEC 13 T 10 R 21W
BOOK PAGE 130 LINE 34

RECEIVED
STATE CORPORATION COMMISSION
10-14-1958
OCT 14 1958

CONSERVATION DIVISION
WICHITA, KANSAS

15-065-19162-00-00

CONTRACTOR'S WELL LOG

OPERATOR D. G. HANSEN FARM NAME BASS #1
 LOCATION SE SE NW Sec. 13-10-21W
 POOL NAME Bass COUNTY Graham STATE Kansas
 COMMENCEMENT DATE November 30, 1952 COMPLETION DATE December 11, 1952

LOG OF WELL

Elevation: 2273 R.B.

All measurements from the top of rotary bushing

FROM	TO	FORMATION	DEVIATION FROM VERTICAL	REMARKS:
0	165			
165	630	Shale-Sand		
630	1040	Shale-Sand		
1040	1230	Shale		
1230	1250	Sand		
1250	1430	Sand		
1430	1735	Red Bed	0° - 1500'	
1735	1778	Anhydrite		
1778	1800	Shale		
1800	2055	Lime-Shale	0° - 2000'	
2055	2245	Lime-Shale		
2245	2400	Lime-Shale		
2400	2465	Lime-Shale		
2465	2565	Lime-Shale	0° - 2500'	
2565	2660	Lime-Shale		
2660	2730	Lime-Shale		
2730	2850	Lime-Shale		
2850	2950	Lime-Shale		
2950	2995	Lime-Shale		
2995	3090	Lime-Shale	0° - 3000'	
3090	3190	Lime-Shale		
3190	3270	Lime-Shale		
3270	3330	Lime-Shale		
3330	3395	Lime-Shale		
3395	3465	Lime-Shale		
3465	3510	Lime-Shale	0° - 3500'	
3510	3550	Lime-Shale		
3550	3605	Lime		
3605	3645	Lime		
3645	3680	Lime		DST 3633'-3645'
3680	3730	Lime		
3730	3805	Lime-Shale		
3805	3830	Lime-Shale		

CASING LEFT IN HOLE AFTER COMPLETION

Ran 165.03' (5 jts.) 8 5/8" OD Casing. w/125 S&C Cement

Set 3846.46' (168 jts.) 5 1/2" OD Casing. w/125 S&C Cement

(17" casing)

STATE OF KANSAS, COUNTY OF SEDGWICK) ss.

The undersigned certifies that to the best of her knowledge and belief, the above facts are true and correct.

C-G DRILLING CO.

Subscribed and sworn to before me this 10th day of December, 1952.

My commission expires: 11/21/55

RECEIVED
 STATE COMMISSION
 09-19-1958
 SEP 19 1958

Notary Public

PLUGGING
 FILE SEC. 13 T. 10 R. 21W
 BOOK PAGE 130 LINE 34