


Give All Information Completely
Make Required Affidavit
Mail or Deliver Report to:
Conservation Division
State Corporation Commission
800 Bittling Building
Wichita, Kansas

OR
FORMATION PLUGGING RECORD

Strike out upper line
when reporting plug-
ging of formations.

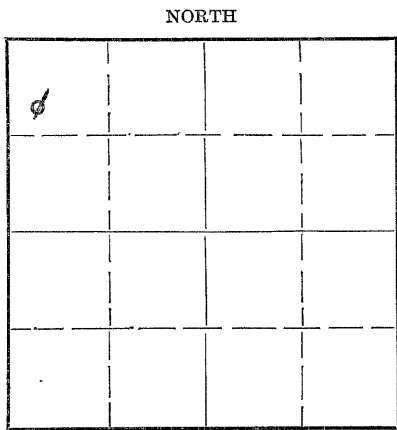

Locate well correctly on above
Section Plat

Location as "NE $\frac{1}{4}$ NW $\frac{1}{4}$ SW $\frac{1}{4}$ " or footage from lines Graham County. Sec. 13 Twp. 10 Rge. 21 (E) W (W) SW NW NW
 Lease Owner D. G. Hansen
 Lease Name Bass "A" Well No. 2
 Office Address Logan, Kansas
 Character of Well (completed as Oil, Gas or Dry Hole) Dry Hole
 Date well completed February 13 19 53
 Application for plugging filed November 26 19 62
 Application for plugging approved November 27 19 62
 Plugging commenced November 26 19 62
 Plugging completed November 26 19 62
 Reason for abandonment of well or producing formation Oil Depleted
 If a producing well is abandoned, date of last production December 19 55
 Was permission obtained from the Conservation Division or its agents before plugging was commenced? Yes

Name of Conservation Agent who supervised plugging of this well Eldon Petty, Hays, Kansas
 Producing formation Arbuckle Depth to top 3796 Bottom Total Depth of Well 3805 Feet
 Show depth and thickness of all water, oil and gas formations.

OIL, GAS OR WATER RECORDS

CASING RECORD

Formation	Content	From	To	Size	Put In	Pulled Out
<u>Arbuckle</u>	<u>Oil to water</u>	<u>3796</u>	<u>3805</u>	<u>8 5/8"</u>	<u>162.18</u>	<u>None</u>
				<u>5 1/2"</u>	<u>3,797</u>	<u>None</u>

Describe in detail the manner in which the well was plugged, indicating where the mud fluid was placed and the method or methods used in introducing it into the hole. If cement or other plugs were used, state the character of same and depth placed, from _____ feet to _____ feet for each plug set.

Mixed 40 sack of mud and pumped down casing. Put in plug and followed with 70 sack cement and one sack hulls. Left standing pressure of approximately 600#.

RECEIVED
STATE CORPORATION COMMISSION

NOV 29 1962
11-29-1962
CONSERVATION DIVISION
Wichita, Kansas

(If additional description is necessary, use BACK of this sheet)

Correspondence regarding this well should be addressed to D. G. Hansen
 Address Logan, Kansas

STATE OF Kansas, COUNTY OF Phillips, ss.
Dane G. Bales (employee of owner) or (~~owner operator~~) of the above-described well,
 being first duly sworn on oath, says: That I have knowledge of the facts, statements, and matters herein contained and the log of the above-described well as filed and that the same are true and correct. So help me God.

(Signature) Dane G. Bales
Logan, Kansas

SUBSCRIBED AND SWORN TO before me this 28th day of November, 19 62

My commission expires Feb. 22 1962 Notary Public.

15-065-03374-00-00

CONTRACTOR'S WELL LOG

OPERATOR D. G. HANSEN FARM NAME BASS "A" #2
 LOCATION SW NW NW Sec. 13-10-21W
 POOL NAME Cooper COUNTY Graham STATE Kansas
 COMMENCEMENT DATE December 21, 1952 COMPLETION DATE January 5, 1953

LOG OF WELL

Elevation: 2255 R. B.
 All measurements from the top of rotary bushing.

FROM	TO	FORMATION	DEVIATION FROM VERTICAL
0	162		
162	740	Sand-Shale	
740	780	Sand	
780	800	Sand-Shale	
800	1205	Shale-Sand	
1205	1340	Sand	
1340	1430	Sand	
1430	1725	Red Bed	0° - 1500'
1725	1769	Anhydrite	
1769	1950	Shale	
1950	2140	Shale	0° - 2000'
2140	2330	Shale-Lime	
2330	2490	Lime-Shale	
2490	2640	Lime-Shale	0° - 2500'
2640	2690	Lime-Shale	
2690	2870	Lime-Shale	
2870	2950	Lime-Shale	
2950	3020	Lime-Shale	0° - 3000'
3020	3115	Lime-Shale	
3115	3220	Lime-Shale	
3220	3300	Lime-Shale	
3300	3380	Lime-Shale	
3380	3415	Lime-Shale	
3415	3480	Lime-Shale	
3480	3530	Lime-Shale	0° - 3500'
3530	3575	Lime	
3575	3617	Lime	
3617	3660	Lime	
3660	3710	Lime	
3710	3755	Lime	
3755	3790	Lime	
3790	3805	Lime	

RECEIVED
 STATE CORPORATION COMMISSION
 NOV 27 1962
 11-27-1962
 COMMISSIONER OF STATE CORP. DIVISION

CASING LEFT IN HOLE AFTER COMPLETION

Ran 162.18' (5 jts.) 8 5/8" OD Casing.
 Set 3826.74' (122 jts.) 5 1/2" OD Casing.

STATE OF KANSAS, COUNTY OF SEDGWICK) ss.

The undersigned certifies that to the best of her knowledge and belief, the above facts are true and correct.

C-G DRILLING CO.

By Vicky Jacobs

Subscribed and sworn to before me this 7th day of January, 1953.

My commission expires: 11/21/55

Marilyn Schmidt
 Notary Public