

15-065-03300-00-20
WELL PLUGGING RECORD

STATE OF KANSAS
 STATE CORPORATION COMMISSION

Give All Information Completely
 Make Required Affidavit
 Mail or Deliver Report to:
 Conservation Division
 State Corporation Commission
 800 Biting Building
 Wichita, Kansas


OR
FORMATION PLUGGING RECORD

Strike out upper line
 when reporting plug-
 ging off formations.

Graham County. Sec. 13 Twp. 10 Rge. 21 (E) W (W)

Location as "NE $\frac{1}{4}$ NW $\frac{1}{4}$ SW $\frac{1}{4}$ " or footage from lines. NW SE NW
 Lease Owner. D. G. Hansen
 Lease Name. Bass "A" Well No. 3
 Office Address. Logan, Kansas
 Character of Well (completed as Oil, Gas or Dry Hole). Dry Hole
 Date well completed. 21 March 19. 53
 Application for plugging filed. 26 November 19. 62
 Application for plugging approved. 27 November 19. 62
 Plugging commenced. 26 November 19. 62
 Plugging completed. 26 November 19. 62
 Reason for abandonment of well or producing formation.
 Oil Depleted
 If a producing well is abandoned, date of last production. December 19. 55
 Was permission obtained from the Conservation Division or its agents before plugging was com-
 menced? Yes

NORTH

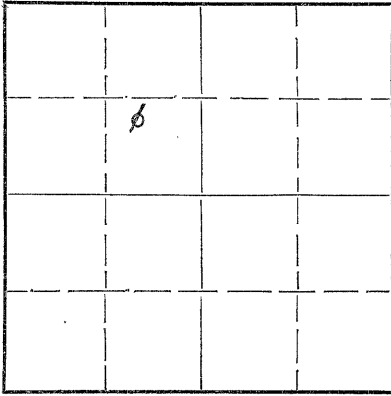

Locate well correctly on above
 Section Plat

Name of Conservation Agent who supervised plugging of this well. Eldon Petty, Hays, Kansas
 Producing formation. Arbuckle Depth to top. 3840 Bottom. Total Depth of Well. 3852 Feet
 Show depth and thickness of all water, oil and gas formations.

OIL, GAS OR WATER RECORDS

CASING RECORD

Formation	Content	From	To	Size	Put In	Pulled Out
Arbuckle	oil to water	3840	3852	8 5/8"	164.96	None
				5 1/2"	3,861	None

Describe in detail the manner in which the well was plugged, indicating where the mud fluid was placed and the method or methods used in introducing it into the hole. If cement or other plugs were used, state the character of same and depth placed, from feet to feet for each plug set.

Mixed 40 sack of mud and pumped down casing. Put in plug and followed with 70 sacks cement and one sack of hulls. Left standing pressure of approximately 600#.

RECEIVED
 STATE CORPORATION COMMISSION

NOV-29 1962

11-29-1962

CONSERVATION DIVISION
 Wichita, Kansas

(If additional description is necessary, use BACK of this sheet)

Correspondence regarding this well should be addressed to D. G. Hansen
 Address. Logan, Kansas

STATE OF Kansas, COUNTY OF Phillips, ss.
 Dane G. Bales (employee of owner) or (owner or operator) of the above-described well,

being first duly sworn on oath, says: That I have knowledge of the facts, statements, and matters herein contained and the log of the above-described well as filed and that the same are true and correct. So help me God.

(Signature) Dane G. Bales
 Logan, Kansas
 (Address)

SUBSCRIBED AND SWORN to before me this 28th day of November, 1962.

My commission expires Feb 22 1962 Notary Public.



OPERATOR D. G. HANSEN FARM NAME BASS "A" #3
 LOCATION NW SE NW Sec. 13-10-21W
 POOL NAME _____ COUNTY Graham STATE Kansas
 COMMENCEMENT DATE February 17, 1953 COMPLETION DATE February 28, 1953

LOG OF WELL

Elevation: 2276 R. B.
 All measurements from the top of rotary bushing.

FROM	TO	FORMATION	DEVIATION FROM VERTICAL	REMARKS:
0	165			
165	1025	Shale-Sand		
1025	1235	Shale-Sand		
1235	1460	Sand		
1460	1742	Redbed	0° - 1500'	
1742	1785	Anhydrite		
1785	2300	Lime-Shale	0° - 2000'	
2300	2430	Lime-Shale		
2430	2500	Lime-Shale	0° - 2500'	
2500	2545	Lime-Shale		
2545	2660	Lime-Shale		
2660	2760	Lime-Shale		
2760	2840	Lime-Shale		
2840	2960	Lime-Shale		
2960	3070	Lime-Shale	0° - 3000'	
3070	3200	Lime-Shale		
3200	3285	Lime-Shale		
3285	3360	Lime-Shale		
3360	3440	Lime-Shale		
3440	3490	Lime-Shale		
3490	3540	Lime-Shale	0° - 3500'	
3540	3575	Lime		
3575	3615	Lime		
3615	3670	Lime		
3670	3725	Lime		
3725	3779	Lime-Shale		
3779	3815	Lime-Shale		
3815	3845	Lime-Shale		
3845	3848	Lime-Shale		
3848	3852	Lime		DST 3840'-3848' DST 3840'-3852'

RECEIVED
 STATE CORPORATION COMMISSION
 NOV 27 1962
 11-27-1962
 CONSERVATION DIVISION
 Wichita, Kansas

CASING LEFT IN HOLE AFTER COMPLETION

Ran 164.96' (5 jts.) 8 5/8" OD Casing.
 Ran 3861.88' (123 jts.) 5 1/2" OD Casing.

STATE OF KANSAS, COUNTY OF SEDGWICK) ss.

The undersigned certifies that to the best of her knowledge and belief, the above facts are true and correct.

C-G DRILLING CO.

By Wicky Jacobs

Subscribed and sworn to before me this 3rd day of March, 1953.

My commission expires: 11/21/55

Marilyn Schmidt
 Notary Public

MAR 6 1953
 D. G. Hansen, Contractor
 By _____