


STATE OF KANSAS
STATE CORPORATION COMMISSION

WELL PLUGGING RECORD

Give All Information Completely
Make Required Affidavit
Mail or Deliver Report to:
Conservation Division
State Corporation Commission
800 Biting Building
Wichita, Kansas

Graham County. Sec. 31 Twp. 9S Rge. 22 (E) W (W)
Location as "NE/CNW $\frac{1}{4}$ SW $\frac{1}{4}$ " or footage from lines SE SE NW
Lease Owner Peel-Hardman
Lease Name Sutor "C" Well No. 1
Office Address P.O. Box 359 Hoisington, Kansas
Character of Well (completed as Oil, Gas or Dry Hole) Dry Hole
Date well completed August 19 19 50
Application for plugging filed August 19 19 50
Application for plugging approved August 19 19 50
Plugging commenced August 19 19 50
Plugging completed August 19 19 50
Reason for abandonment of well or producing formation Dry Hole

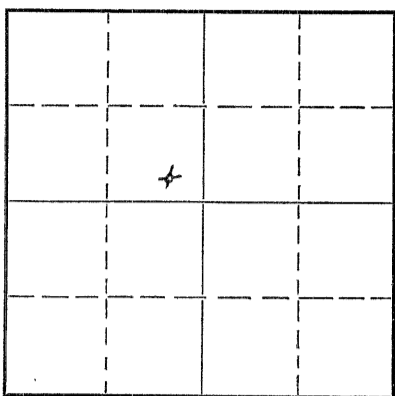

Locate well correctly on above
Section Plat

If a producing well is abandoned, date of last production _____ 19____
Was permission obtained from the Conservation Division or its agents before plugging was com-
menced? Yes

Name of Conservation Agent who supervised plugging of this well E. R. Petty
Producing formation _____ Depth to top _____ Bottom _____ Total Depth of Well 4020 Feet
Show depth and thickness of all water, oil and gas formations.

OIL, GAS OR WATER RECORDS

CASING RECORD

Formation	Content	From	To	Size	Put In	Pulled Out
		0	163'	8 5/8"	163'	None

Describe in detail the manner in which the well was plugged, indicating where the mud fluid was placed and the method or methods used in introducing it into the hole. If cement or other plugs were used, state the character of same and depth placed, from _____ feet to _____ feet for each plug set.

From 4020' to 161 $\frac{1}{2}$ ' - Heavy Rotary Mud
" 161 $\frac{1}{2}$ ' to 160' - Wooden Plug
" 160' to 114' - 15 sacks cement
" 114' to 41 $\frac{1}{2}$ ' - Heavy Rotary Mud
" 41 $\frac{1}{2}$ ' to 40' - Wooden Plug
" 40' to 6' - 10 sacks cement
" 6' to surface - Cellar

RECEIVED
COPY 8/28/50
AUG 28 1950
STATE CORPORATION
COMMISSION
KANSAS

(If additional description is necessary, use BACK of this sheet)


Correspondence regarding this well should be addressed to Peel-Hardman
Address P. O. Box 359 Hoisington, Kansas

STATE OF Kansas, COUNTY OF Barton, ss.
Glenn Peel Drilling Company, Inc. (employee of owner) or (owner or operator) of the above-described well,
being first duly sworn on oath, says: That I have knowledge of the facts, statements, and matters herein contained and the log of the above-
described well as filed and that the same are true and correct. So help me God. Glenn Peel Drilling Company, Inc.

(Signature) BY: Glenn Peel
P.O. BOX 359 HOISINGTON, KANSAS
(Address)

SUBSCRIBED AND SWORN to before me this 26th day of August, 19 50

My commission expires June 4, 1951 Marion M. Herbert Notary Public.

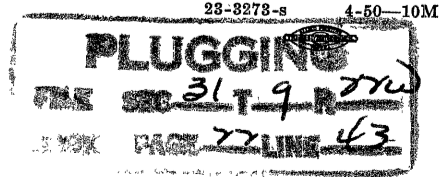

DRILLER'S LOG

Company: Peel-Hardman

Sec. 31 Twp. 9S Rge. 22W
SE SE NW

Farm: Sutor "C" Well No. 1

Total Depth: 4020'

County: Graham,
Kansas

Comm: 8-10-50 Comp: 8-19-50

Contractor: Glenn Peel Drilling Co., Inc.

Elevation:

Casing: 8 5/8" 163' cem.

Production: Dry

Figures below indicate bottom of formations

Clay & Rock	0-	45
Sand & Shale		163
Shale		780
Shale & Sand		1420
Sand		1630
Shale W/ Sand Streaks		1665
Shale		1890
Anhydrite		1925
Shale		2005
Shale & Shells		2415
Shale & Lime		2700
Lime & Shale		3500
Lime		3880
Conglomerate		3925
Lime		4020
Total Depth		4020

This is to certify that the above information is, to the best of our knowledge, true and correct.

GLENN PEEL DRILLING COMPANY, INC.

BY: Mendell L. PeelSUBSCRIBED AND SWORN to before me this 26th day of August, 1950My commission expires June 4, 1951 Marvin M. Herber