


WELL PLUGGING RECORD

Give All Information Completely
Make Required Affidavit
Mail or Deliver Report to:
Conservation Division
State Corporation Commission
212 North Market, Insurance Bldg.
Wichita, Kansas

NORTH

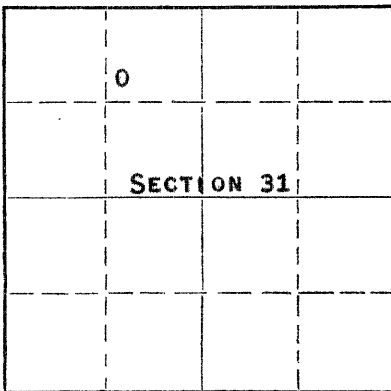

Locate well correctly on above
Section Plat

GRAHAM County. Sec. 31 Twp. 9S Rge. 22W (#) (W)
Location as "NE/CNW/SW" or footage from lines SE NW NW
Lease Owner PETROLEUM, INC.
Lease Name SUTOR "D" Well No. 1
Office Address ROUTE 2, GREAT BEND, KANSAS
Character of Well (completed as Oil, Gas or Dry Hole) DRY HOLE
Date well completed NOVEMBER 9 1959
Application for plugging filed NOVEMBER 9 1959
Application for plugging approved NOVEMBER 9 1959
Plugging commenced NOVEMBER 9 1959
Plugging completed NOVEMBER 9 1959
Reason for abandonment of well or producing formation NO PRODUCIBLE ZONES

If a producing well is abandoned, date of last production NONE 19
Was permission obtained from the Conservation Division or its agents before plugging was commenced? YES

Name of Conservation Agent who supervised plugging of this well A. D. FABRICIUS, BOX 731, HILL CITY, KANSAS
Producing formation --- Depth to top --- Bottom --- Total Depth of Well 3890 Feet
Show depth and thickness of all water, oil and gas formations.

OIL, GAS OR WATER RECORDS

CASING RECORD

FORMATION	CONTENT	FROM	TO	SIZE	PUT IN	PULLED OUT
				8-5/8"	284'	NONE

Describe in detail the manner in which the well was plugged, indicating where the mud fluid was placed and the method or methods used in introducing it into the hole. If cement or other plugs were used, state the character of same and depth placed, from feet to feet for each plug set.

MUD UP WITH HEAVY MUD TO 500' FOLLOWED BY A WOODEN PLUG. PLACED 20 SACKS OF CEMENT THROUGH DRILL PIPE ON TOP OF PLUG. MUD UP TO 280' FOLLOWED BY A WOODEN PLUG. PLACED 20 SACKS OF CEMENT THROUGH DRILL PIPE ON TOP OF PLUG. MUD UP TO 40' FOLLOWED BY 1/4 SACK OF HULLS AND A WOODEN PLUG. FILLED HOLE TO BASE OF WELL CELLAR WITH 10 SACKS OF CEMENT.

RECEIVED
STATE CORPORATION COMMISSION

11/30/59
NOV 30 1959

CONSERVATION DIVISION
Wichita, Kansas

(If additional description is necessary, use BACK of this sheet)
Name of Plugging Contractor GARVEY DRILLING COMPANY
Address ROUTE 2, GREAT BEND, KANSAS

STATE OF KANSAS, COUNTY OF BARTON, ss.
DON SEARLE (employee of owner) or (***** of the above-described well, being first duly sworn on oath, says: That I have knowledge of the facts, statements, and matters herein contained and the log of the above-described well as filed and that the same are true and correct. So help me God.

(Signature) Don Searle
ROUTE 2, GREAT BEND, KANSAS

(Address)

SUBSCRIBED AND SWORN TO before me this 25TH day of NOVEMBER, 1959

My commission expires APRIL 14, 1963

Arthur J. Miles
Notary Public.



WELL LOG

15-065-02127-00-00

COMPANY PETROLEUM, INCORPORATED

SEC. 31 T. 9S R. 22W

FARM SUTOR "D" NO. 1


LOC. SE, NW, NW

TOTAL DEPTH 3890'

COUNTY GRAHAM CO., KANSAS

COMM. November 1, 1959 COMP. November 9, 1959

CONTRACTOR GARVEY DRILLING COMPANY

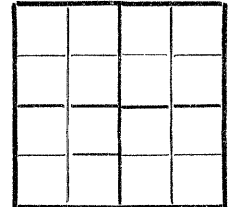

CASING 8 5/8" @ 284' W/225 sax.

ELEVATION

PRODUCTION D & A

FIGURES INDICATE BOTTOM OF FORMATIONS

284	Surface soil & shale
860	Shale
1463	Shale & shells
1700	Sand
1908	Red bed & shale
1943	Anhydrite
2345	Shale
2580	Shale & lime
3890	Lime & shale
3890	T. D.

RECEIVED
STATE CORPORATION COMMISSION

NOV 30 1959

CONSERVATION DIVISION
Wichita, Kansas

State of KANSAS
County of BARTON } ss:

I, VERNE A. MORRIS of GARVEY DRILLING COMPANY

upon oath state that the above and foregoing is a true and correct copy of the log of the #1 SUTOR "D" well.

Verne A. Morris

Subscribed and sworn to before me this 20th day of November 19 59

My Commission Expires: April 14, 1963

Arthur J. Miles
NOTARY PUBLIC