


WELL PLUGGING RECORD

Give All Information Completely
Make Required Affidavit
Mail or Deliver Report to:
Conservation Division
State Corporation Commission
211 No. Broadway
Wichita, Kansas

GRAHAM County, Sec. 31 Twp. 9s Rge. 22W (X) (W)

Location as "NE/CNW%SW%" or footage from lines C SE SE
Lease Owner PETROLEUM, INC.,
Lease Name SUTOR "G" Well No. 1
Office Address ROUTE 2, GREAT BEND, KANSAS
Character of Well (completed as Oil, Gas or Dry Hole) DRY HOLE
Date well completed JUNE 15, 1963
Application for plugging filed JUNE 15, 1963
Application for plugging approved JUNE 15, 1963
Plugging commenced JUNE 15, 1963
Plugging completed JUNE 15, 1963
Reason for abandonment of well or producing formation NO PRODUCIBLE FORMATIONS

NORTH

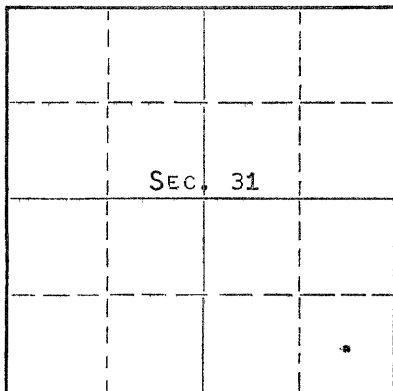

Locate well correctly on above
Section Plat

If a producing well is abandoned, date of last production NONE 19
Was permission obtained from the Conservation Division or its agents before plugging was commenced? YES

Name of Conservation Agent who supervised plugging of this well W. L. NICHOLS
Producing formation --- Depth to top --- Bottom --- Total Depth of Well 3840 Feet
Show depth and thickness of all water, oil and gas formations.

OIL, GAS OR WATER RECORDS

CASING RECORD

FORMATION	CONTENT	FROM	TO	SIZE	PUT IN	PULLED OUT
				8-5/8"	258'	NONE

Describe in detail the manner in which the well was plugged, indicating where the mud fluid was placed and the method or methods used in introducing it into the hole. If cement or other plugs were used, state the character of same and depth placed, from _____ feet to _____ feet for each plug set.

MUDDED UP WITH HEAVY MUD TO 540', FOLLOWED BY WOODEN PLUG AND 1/4 SACK HULLS.
PLACED 20 SACKS CEMENT THROUGH DRILL PIPE ONTO HULLS. MUDDED UP WITH HEAVY
MUD TO 230', FOLLOWED BY WOODEN PLUG AND 1/4 SACK HULLS. PLACED 20 SACKS
CEMENT THROUGH DRILL PIPE ONTO HULLS. MUDDED UP WITH HEAVY MUD TO 40',
FOLLOWED BY WOODEN PLUG, 1/4 SACK HULLS AND 10 SACKS CEMENT TO BASE OF WELL
CELLAR.

RECEIVED
STATE CORPORATION COMMISSION
6/20/63
JUN 20 1963

(If additional description is necessary, use BACK of this sheet)
Name of Plugging Contractor GARVEY DRILLING COMPANY
Address ROUTE 2, GREAT BEND, KANSAS

STATE OF KANSAS, COUNTY OF BARTON, ss.
DON SEARLE

(employee of owner) or (owner) of the above-described well, being first duly sworn on oath, says: That I have knowledge of the facts, statements, and matters herein contained and the log of the above-described well as filed and that the same are true and correct. So help me God. DON SEARLE, DIST. PROD. SUPT.

(Signature) Don Searle
ROUTE 2, GREAT BEND, KANSAS
(Address)

SUBSCRIBED AND SWORN TO before me this 20TH day of JUNE, 1963

My commission expires APRIL 14, 1963 Arthur J. Miles Notary Public.

WELL LOG 15-065-02128-00-00

COMPANY Petroleum Inc.

SEC. 31 T. 9S R. 22W

FARM Sutor "G"

NO. 1

LOC. C SE SE


TOTAL DEPTH 3840'

COUNTY Graham

COMM. 6-7-63

COMP. 6-15-63

CONTRACTOR Garvey Drilling Company

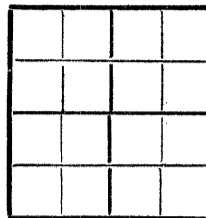

CASING 8-5/8" @ 258' w/250 sx.

ELEVATION 2331' KB

PRODUCTION D & A

FIGURES INDICATE BOTTOM OF FORMATIONS

- 40' Clay
- 100' Sandy Clay & Shale
- 160' Shale
- 258' Shale
- 1435' Shale & Shells
- 1876' Shale & Red Bed
- 1917' Anhydrite
- 2150' Shale & Red Bed
- 2465' Shale & Shells
- 2655' Shale & Lime
- 2815' Lime & Shale
- 2950' Shale & Lime
- 3095' Lime & Shale
- 3525' Lime
- 3840' Lime
- 3840' R.T.D.

RECEIVED
STATE CORPORATION

JUN 20 1963

CONSERVATION
Wichita, Kansas

State of ~~Missouri~~ Kansas }
County of Barton } ss

I, O. Brandenburg of Garvey Drilling Co.

upon oath state the above and foregoing is a true and correct copy of the log of the Sutor "G" #1 well.

Subscribed and sworn to before me this 19th day of June 19 63

My Commission Expires: April 14, 1967

 O. Brandenburg

 Archer J. Wiles
NOTARY PUBLIC