


Give All Information Completely  
Make Required Affidavit  
Mail or Deliver Report to:  
Conservation Division  
State Corporation Commission  
211 No. Broadway  
Wichita, Kansas

WELL PLUGGING RECORD

Sedgwick County, Sec. 4 Twp. 26 Rge. 2 (E) ~~(W)~~  
Location as "NE/CNW/SW" or footage from lines SE SE NW  
Lease Owner Acme Oil Corporation  
Lease Name Kober Korber Well No. 1  
Office Address 404 One Twenty Bldg., Wichita, Kansas  
Character of Well (completed as Oil, Gas or Dry Hole) oil well  
Date well completed 1-31-61 19  
Application for plugging filed 8-20-65 19  
Application for plugging approved 8-22-65 19  
Plugging commenced 8-30-65 19  
Plugging completed 9-3-65 19  
Reason for abandonment of well or producing formation depleted

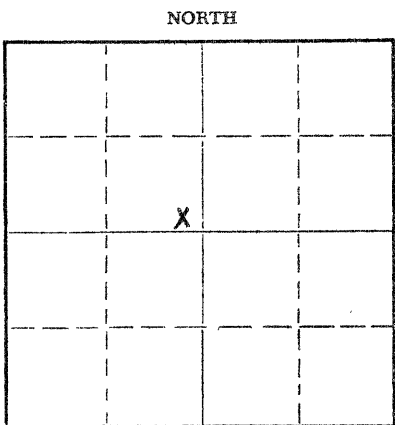

Locate well correctly on above  
Section Plat

If a producing well is abandoned, date of last production \_\_\_\_\_ 19\_\_\_\_  
Was permission obtained from the Conservation Division or its agents before plugging was commenced? yes

Name of Conservation Agent who supervised plugging of this well Paul Turpin  
Producing formation \_\_\_\_\_ Depth to top \_\_\_\_\_ Bottom \_\_\_\_\_ Total Depth of Well 2924 Feet  
Show depth and thickness of all water, oil and gas formations.

OIL, GAS OR WATER RECORDS

CASING RECORD

FORMATION	CONTENT	FROM	TO	SIZE	PUT IN	PULLED OUT
				8 5/8	157	none
				4 1/2	2916	2237.18

Describe in detail the manner in which the well was plugged, indicating where the mud fluid was placed and the method or methods used in introducing it into the hole. If cement or other plugs were used, state the character of same and depth placed, from \_\_\_\_\_ feet to \_\_\_\_\_ feet for each plug set.

Fill hole to 2915' with chat and dump 5 sacks cement.  
Set 15' rock bridge from 200' to 185' and dump 20 sacks cement.  
Mud hole to 30' and dump 10 sacks cement.

RECEIVED  
STATE CORPORATION COMMISSION

SEP 17 1965

CONSERVATION DIVISION  
Wichita, Kansas

(If additional description is necessary, use BACK of this sheet)  
Name of Plugging Contractor Flint Engineering & Construction Company  
Address Box 950, El Dorado, Kansas

STATE OF KANSAS, COUNTY OF BUTLER, ss.  
\_\_\_\_\_(employee of owner) or (owner or operator) of the above-described well, being first duly sworn on oath, says: That I have knowledge of the facts, statements, and matters herein contained and the log of the above-described well as filed and that the same are true and correct. So help me God.

(Signature) Gauss Bawdle  
El Dorado, Kansas  
(Address)

SUBSCRIBED AND SWORN to before me this 13th day of September, 19 65

My commission expires 9-27-67 Ronald R. Hanson Notary Public.

Acme Oil Co

4-26-2E

COMPANY: Bill H. Kucera  
 LEASE: Korber #1  
 LOCATION: SE SE NW Sec. 4-26-2E  
 Sedgwick County, Kansas  
 CONTRACTOR: Gearhart-Canaday Drilling Co.  
 CASING: 187' 5/8" 1/100 Sacks Cement  
 2916' 4 1/2" 1/75 Sacks Cement

COMMENCED: 1-23-61  
 COMPLETED: 1-31-61  
 TOTAL DEPTH: 2924'

FIGURES INDICATE BOTTOM OF FORMATION

23'	Soll	2620'	Line
100'	Line & Shale	2660'	Line Shale
250'	Line	2755'	Shale & Line
420'	Line & Shale	2920'	Line & Shale
465'	Line	2924'	Sand
665'	Shale & Line	2924'	T.D.
954'	Shale Line		
1200'	Shale & Shells		
1430'	Shale		
1530'	Line		
1630'	Line Shale		
1670'	Line		
1705'	Line Shale		
1820'	Shale & Line		
2050'	Line & Shale		
2150'	Sand		
2205'	Line		
2405'	Shale & Line		

I, Gerald W. Gearhart, of Gearhart-Canaday Drilling Company, certify the above rotary log to be true & correct.

*Gerald W. Gearhart*  
 Gerald W. Gearhart, Partner  
 Gearhart-Canaday Drilling Co.

Subscribed and sworn to before me,  
 a notary public in and for Sedgwick  
 County, Kansas, this 20th day of  
 February, 1961.

*G. E. Canaday*  
 My commission expires Sept. 13, 1962

**RECEIVED**  
 STATE CORPORATION COMMISSION

SEP 17 1965

CONSERVATION DIVISION  
 Wichita, Kansas