


Get All Information Completely
Make Required Affidavit
Mail or Deliver Report to:
Conservation Division
State Corporation Commission
211 No. Broadway
Wichita, Kansas

15-173-00402-00-00
WELL PLUGGING RECORD

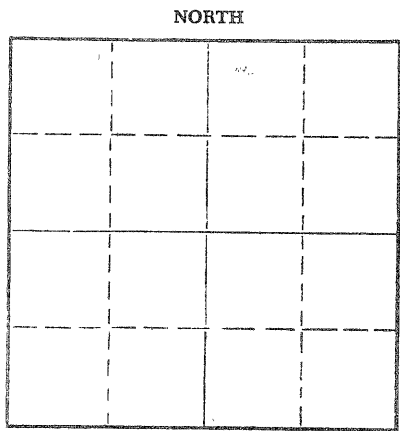

Locate well correctly on above Section Plat

Sedgwick County. Sec. 4 Twp. 26 Rge. 2 (E) E (W)
Location as "NE/CNW%SW%" or footage from lines SE SE NE
Lease Owner Jenkins-Ray Supply
Lease Name Feik Well No. 1
Office Address Box 967, Ponca, City, Oklahoma
Character of Well (completed as Oil, Gas or Dry Hole) Dry Hole
Date well completed _____ 19____
Application for plugging filed _____ 19____
Application for plugging approved _____ 19____
Plugging commenced 5-22-62 _____ 19____
Plugging completed 5-24-62 _____ 19____
Reason for abandonment of well or producing formation Dry Hole

If a producing well is abandoned, date of last production _____ 19____
Was permission obtained from the Conservation Division or its agents before plugging was commenced? Yes

Name of Conservation Agent who supervised plugging of this well Lee Guthrie
Producing formation _____ Depth to top _____ Bottom _____ Total Depth of Well 2975 Feet
Show depth and thickness of all water, oil and gas formations.

OIL, GAS OR WATER RECORDS

CASING RECORD

FORMATION	CONTENT	FROM	TO	SIZE	PUT IN	PULLED OUT
				8 5/8"	125'	None
				4 1/2"	2975'	2738'

Describe in detail the manner in which the well was plugged, indicating where the mud fluid was placed and the method or methods used in introducing it into the hole. If cement or other plugs were used, state the character of same and depth placed, from _____ feet to _____ feet for each plug set.

Filled with gravel to 2967' and dumped 4 sacks cement. Shot pipe at 2738'
Set rock bridge from 180' to 161' and cemented to surface

RECEIVED
STATE CORPORATION COMMISSION
6/8/62
JUN 8 1962
CONSERVATION DIVISION
Wichita, Kansas

(If additional description is necessary, use BACK of this sheet)
Name of Plugging Contractor Albert Leach
Address Sterling, Colorado

STATE OF Oklahoma, COUNTY OF Kay, ss.
G.T. Ray (employee of owner) or (owner or operator) of the above-described well, being first duly sworn on oath, says: That I have knowledge of the facts, statements, and matters herein contained and the log of the above-described well as filed and that the same are true and correct. So help me God.

(Signature) _____
Box 967, Ponca City, Oklahoma
(Address)

SUBSCRIBED AND SWORN TO before me this 5th day of June, 19 62

Nasmi Baker
Notary Public.

My commission expires 8-3-63