


Give All Information Completely
Make Required Affidavit
Mail or Deliver Report to:
Conservation Division
State Corporation Commission
211 No. Broadway
Wichita, Kansas

WELL PLUGGING RECORD

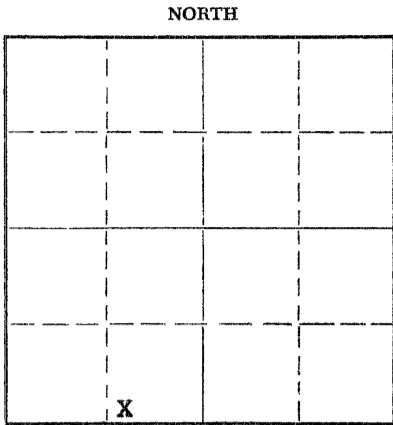

Locate well correctly on above Section Plat

Sedgwich County. Sec. 2 Twp. 26 1/2 Rge. 2 (E) (W) (XX)
Location as "NE/CNW/SW" or footage from lines SW/SE/SW
Lease Owner Winne Oil Co
Lease Name Penner Well No. 1
Office Address 3856 N. Oliver Wichita, Kansas
Character of Well (completed as Oil, Gas or Dry Hole) Oil
Date well completed 7-11-58 19
Application for plugging filed 7-5-58 19
Application for plugging approved 7-8-58 19
Plugging commenced 7-11-58 8:00 am 19
Plugging completed 1.30 pm 7-14-58 19
Reason for abandonment of well or producing formation no production

If a producing well is abandoned, date of last production not known 19
Was permission obtained from the Conservation Division or its agents before plugging was commenced? Yes

Name of Conservation Agent who supervised plugging of this well Gene Graham
Producing formation Missippi chat Depth to top 2853 Bottom 2870 Total Depth of Well 2920 Feet
Show depth and thickness of all water, oil and gas formations.

OIL, GAS OR WATER RECORDS

CASING RECORD

FORMATION	CONTENT	FROM	TO	SIZE	PUT IN	PULLED OUT
				8 5/8"	150'	left in ground
				4 1/2"	2918'	2447'

Describe in detail the manner in which the well was plugged, indicating where the mud fluid was placed and the method or methods used in introducing it into the hole. If cement or other plugs were used, state the character of same and depth placed, from _____ feet to _____ feet for each plug set.

2858' - 5' rock - 4 sacks of cement, dumped wet with bailer - 175' - 10' rock - 15 sacks of cement dry - mudded up to 20' - 5 sacks cement dry - filled up to top of surface pipe

(If additional description is necessary, use BACK of this sheet)
Name of Plugging Contractor Kent Well Servicing Company
Address Box 667 - 2011 W. 6th - El Dorado, Kansas

STATE OF Kansas, COUNTY OF Butler, ss.
C. D. Payne (employee of owner) or (owner or operator) of the above-described well, being first duly sworn on oath, says: That I have knowledge of the facts, statements, and matters herein contained and the log of the above-described well as filed and that the same are true and correct. So help me God.

(Signature) C. D. Payne
Box 667, El Dorado, Kansas
(Address)

SUBSCRIBED AND SWORN TO before me this 31 day of July, 19 58

My commission expires 3-14-1960
Velvet H. Stotts Notary Public.

PLUGGING
FILE SEC 2 T 26 1/2 E
BOOK PAGE 112 LINE 29

8-5-58