

15-173-01915-00-00

STATE OF KANSAS
STATE CORPORATION COMMISSION


WELL PLUGGING RECORD

Give All Information Completely
Make Required Affidavit
Mail or Deliver Report to:
Conservation Division
State Corporation Commission
211 No. Broadway
Wichita, Kansas

Sedgwich County. Sec. 2 Twp. 26S Rge. 2 (E) (W)

Location as "NE/CNW%SW%" or footage from lines SW/NE/SW
Lease Owner Winne Oil Co
Lease Name Lohrenz Well No. 1
Office Address 3856 N. Oliver, Wichita, Kansas
Character of Well (completed as Oil, Gas or Dry Hole) Oil
Date well completed 7-21-57 19
Application for plugging filed 7-5-58 19
Application for plugging approved 7-8-58 19
Plugging commenced AM 9:00 July 9th, 1958 19
Plugging completed 10:00 AM July 11th, 1958 19
Reason for abandonment of well or producing formation stoped producing

NORTH

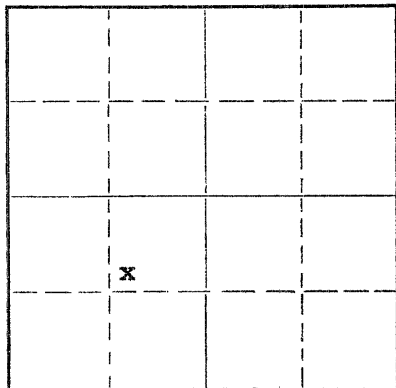

Locate well correctly on above
Section Plat

If a producing well is abandoned, date of last production not known 19
Was permission obtained from the Conservation Division or its agents before plugging was commenced? yes

Name of Conservation Agent who supervised plugging of this well Gene Graham
Producing formation Mississippi Depth to top 2872 Bottom 2893 Total Depth of Well 2940 Feet

Show depth and thickness of all water, oil and gas formations.

OIL, GAS OR WATER RECORDS

CASING RECORD

FORMATION	CONTENT	FROM	TO	SIZE	PUT IN	PULLED OUT
				8 5/8"	150'	left in grd.
				4 1/2"	2940'	2326'

Describe in detail the manner in which the well was plugged, indicating where the mud fluid was placed and the method or methods used in introducing it into the hole. If cement or other plugs were used, state the character of same and depth placed, from _____ feet to _____ feet for each plug set.

2868' - 3' rock - 4 sacks of cement dumped wet, with bailer, 170' - 10' mud on top of bridge - dumped 15 sacks of cement dry, mudded up to 20'
20' - dumped 5 sacks of cement dry, filled on up to top

(If additional description is necessary, use BACK of this sheet)

Name of Plugging Contractor Kent Well Servicing Company
Address Box 667 - 2011 W. 6th - El Dorado, Kansas

STATE OF Kansas, COUNTY OF Butler, ss.
C. D. Payne (employee of owner) or (owner or operator) of the above-described well, being first duly sworn on oath, says: That I have knowledge of the facts, statements, and matters herein contained and the log of the above-described well as filed and that the same are true and correct. So help me God.

(Signature) C. D. Payne

Box 667 El Dorado, Kansas (Address)

SUBSCRIBED AND SWORN TO before me this 31 day of July, 1958

Velma H. Stewart
Notary Public.

My commission expires 3-14-1960

PLUGGING
FILE SEC 2 T 26 R 2 E
BOOK PAGE 112 LINE 28

AUG 5 1958
8-5-58
CONSERVATION DIVISION