


*R*

WELL PLUGGING RECORD

Give All Information Completely  
Make Required Affidavit  
Mail or Deliver Report to:  
Conservation Division  
State Corporation Commission  
211 No. Broadway  
Wichita, Kansas

NORTH

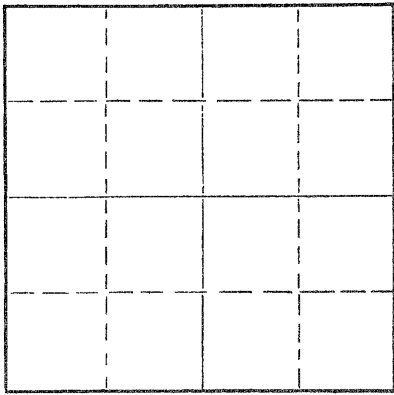

Locate well correctly on above  
Section Plat

Sedgwick County. Sec. 2 Twp. 26S Rge. 2 (E) (W)  
Location as "NE/CNW/SW" or footage from lines NW NW SW  
Lease Owner George R. Hess  
Lease Name Penner Well No. 1  
Office Address 505 N. Charles McPherson, Kans.  
Character of Well (completed as Oil, Gas or Dry Hole) Dry Hole  
Date well completed 4-29 19 63  
Application for plugging filed 4-29 19 63  
Application for plugging approved 4-29 19 63  
Plugging commenced 4-29 19 63  
Plugging completed 4-29 19 63  
Reason for abandonment of well or producing formation Dry Hole

If a producing well is abandoned, date of last production \_\_\_\_\_ 19\_\_\_\_  
Was permission obtained from the Conservation Division or its agents before plugging was commenced? yes

Name of Conservation Agent who supervised plugging of this well Paul Turpin  
Producing formation \_\_\_\_\_ Depth to top \_\_\_\_\_ Bottom \_\_\_\_\_ Total Depth of Well 2918 Feet  
Show depth and thickness of all water, oil and gas formations.

OIL, GAS OR WATER RECORDS

CASING RECORD

FORMATION	CONTENT	FROM	TO	SIZE	PUT IN	PULLED OUT
Surface Casing				8-5/8	150'	none

Describe in detail the manner in which the well was plugged, indicating where the mud fluid was placed and the method or methods used in introducing it into the hole. If cement or other plugs were used, state the character of same and depth placed, from \_\_\_\_\_ feet to \_\_\_\_\_ feet for each plug set.

Filled hole with mud to 200 feet. Set bottom plug at 200 feet. 20 sacks of cement on plug an 1/4 sack of hulls. Mud to 30 feet. 1/4 sack of hulls and 8 sacks of cement on plug to top of hole. 2 sacks of cement in rat hole.

RECEIVED  
STATE CORPORATION COMMISSION

MAY 2 1963

S-2-63

CONSERVATION DIVISION  
Wichita, Kansas

(If additional description is necessary, use BACK of this sheet)

Name of Plugging Contractor SeROBee Drilling Co., Inc.  
Address 5301 N. Broadway Wichita, Kans.

STATE OF Kansas, COUNTY OF Sedgwick, ss.  
Paul S. Septer (employee of owner) or (owner or operator) of the above-described well, being first duly sworn on oath, says: That I have knowledge of the facts, statements, and matters herein contained and the log of the above-described well as filed and that the same are true and correct. So help me God. SeROBee Drilling Co., Inc.

(Signature) Paul S. Septer  
Paul S. Septer, President  
5301 N. Broadway Wichita, Kans.  
(Address)

SUBSCRIBED AND SWORN to before me this 30th day of April 1963

My commission expires Dec. 28, 1966

Wally D. Jarvis  
Notary Public.



KANSAS GEOLOGICAL SOCIETY  
 KANSAS WELL LOG BUREAU - KANSAS WELL SAMPLE BUREAU  
 KANSAS GEOLOGICAL SOCIETY BUILDING  
 508 EAST MURDOCK - WICHITA, KANSAS

①

COMPANY George Hess

SEC. 2 T. 26S R. 2E

FARM Penner

NO. 1

LOC. NW NW SW

TOTAL DEPTH 2918'

COUNTY Sedgwick

COMM. 4-22-63


COMP. 4-29-63

KANSAS

SHOT OR TREATED

CONTRACTOR SeRoBee Drilling Co., Inc.

ISSUED

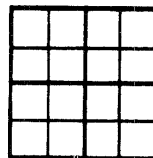

CASING

20	10	
15	8	150' W/125 sacks
12	6	
13	5	

ELEVATION 1385 KB

PRODUCTION D & A

FIGURES INDICATE BOTTOM OF FORMATIONS

0	-	80	Top soil & clay
80	-	2340	Lime & shale
2340	-	2439	Lime
2439	-	2606	Kansas City
2606	-	2886	Lime & shale
2886	-	2894	Cherty Conglomerate
2894	-	2918	Mississippi
		2918	TD

RECEIVED  
 STATE CORPORATION COMMISSION

MAY 2 1963

CONSERVATION DIVISION  
 WICHITA, KANSAS