


Give All Information Completely  
Make Required Affidavit  
Mail or Deliver Report to:  
Conservation Division  
State Corporation Commission  
211 No. Broadway  
Wichita, Kansas

WELL PLUGGING RECORD

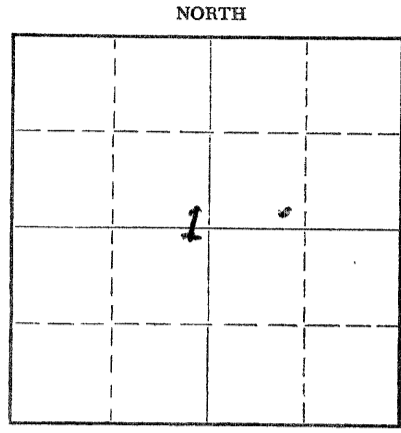

Locate well correctly on above Section Plat

Sedgwick County. Sec. 1 Twp. 26S Rge. 2 (E) (XXX)  
 Location as "NE/CNW/SW" or footage from lines SE SW NE  
 Lease Owner Warren R. Winne (Formerly Aurora Gasoline Co.)  
 Lease Name Bertschinger Well No. 1  
 Office Address 3856 N. Oliver - Wichita, Kansas  
 Character of Well (completed as Oil, Gas or Dry Hole) Oil  
 Date well completed 12-4 1958  
 Application for plugging filed 7-25 1959  
 Application for plugging approved 7-28 File #54-2 19 59  
 Plugging commenced 7 A.M. XXX 8-4 1959  
 Plugging completed 1 P.M. 8-6 1959  
 Reason for abandonment of well or producing formation Quit Producing

If a producing well is abandoned, date of last production \_\_\_\_\_ 19\_\_\_\_  
 Was permission obtained from the Conservation Division or its agents before plugging was commenced? Yes

Name of Conservation Agent who supervised plugging of this well Lee Guthrie  
 Producing formation Mississippi Depth to top 2821 Bottom 2829 Total Depth of Well 2882 Feet  
 Show depth and thickness of all water, oil and gas formations.

OIL, GAS OR WATER RECORDS

CASING RECORD

FORMATION	CONTENT	FROM	TO	SIZE	PUT IN	PULLED OUT
		Surface	2863'	4 1/2" O.D.	2863'	2197.15'
		Surface	99'	8 5/8" O.D.	99'	Circulated W/C

Describe in detail the manner in which the well was plugged, indicating where the mud fluid was placed and the method or methods used in introducing it into the hole. If cement or other plugs were used, state the character of same and depth placed, from \_\_\_\_\_ feet to \_\_\_\_\_ feet for each plug set.

Run Tools Found T.D. 2455 Ft.  
Set bridge 5 sacks cement at 2455 Ft.  
Set bridge of 15 ft. rock and dumped 25 sacks cement at 175 ft.  
Filled to 35 ft. with mud.  
Set bridge at 35 ft. with 5 ft. rock and 10 sacks cement.  
8 5/8" O.D. surface casing cut off 3 ft. below surface and steel cap welded on top of casing.

8-11-59

(If additional description is necessary, use BACK of this sheet)  
 Name of Plugging Contractor Kent well servicing company  
 Address Box 667 - 2375 W. Central - El Dorado, Kansas

STATE OF Kansas, COUNTY OF Butler, ss.  
 \_\_\_\_\_ (employee of owner) or (owner or operator) of the above-described well, being first duly sworn on oath, says: That I have knowledge of the facts, statements, and matters herein contained and the log of the above-described well as filed and that the same are true and correct. So help me God.

(Signature) E. D. Payne  
 \_\_\_\_\_ (Address)

SUBSCRIBED AND SWORN TO before me this 10th day of August, 19 59.

My commission expires June 18, 1963  
Estelene C. Phillips Notary Public.

PLUGGING  
 FILE SEC. 1 T. 26 R. 2E  
 BOOK PAGE 54 LINE 2