

R


STATE OF KANSAS
STATE CORPORATION COMMISSION

Give All Information Completely
Make Required Affidavit
Mail or Deliver Report to:
Conservation Division
State Corporation Commission
211 No. Broadway
Wichita, Kansas

WELL PLUGGING RECORD

Sedgwick County. Sec. 1 Twp. 26 Rge. 2 (E) 1/4/1

Location as "NE/CNW%SW%" or footage from lines NE NW SE
Lease Owner Kent Well Servicing Co., Inc.
Lease Name Edson Well No. 1
Office Address Box 470, El Dorado, Kansas
Character of Well (completed as Oil, Gas or Dry Hole) oil
Date well completed 2-19 19 56
Application for plugging filed 10-31 19 62
Application for plugging approved 11-01 19 62
Plugging commenced 11-04 19 62
Plugging completed 11-06 19 62
Reason for abandonment of well or producing formation low production

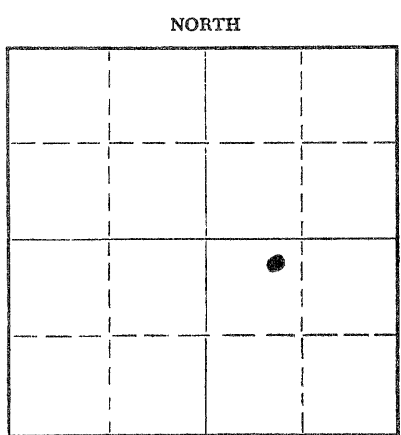

Locate well correctly on above
Section Plat

If a producing well is abandoned, date of last production _____ 19 ____
Was permission obtained from the Conservation Division or its agents before plugging was commenced? yes

Name of Conservation Agent who supervised plugging of this well Paul Turpin
Producing formation _____ Depth to top _____ Bottom _____ Total Depth of Well 2871 Feet
Show depth and thickness of all water, oil and gas formations.

OIL, GAS OR WATER RECORDS

CASING RECORD

FORMATION	CONTENT	FROM	TO	SIZE	PUT IN	PULLED OUT
				8 5/8	93 1/2	cemented
				5 1/2	2871	2398.18

Describe in detail the manner in which the well was plugged, indicating where the mud fluid was placed and the method or methods used in introducing it into the hole. If cement or other plugs were used, state the character of same and depth placed, from _____ feet to _____ feet for each plug set.

Filled with sand to 2803 feet, dumped 5 sacks cement.

Set 20 foot rock bridge at 150 feet, dumped 20 sacks cement.

Filled with mud to 25 feet, dumped 8 sacks cement

RECEIVED
STATE CORPORATION COMMISSION

NOV 15 1962
11-15-62

CONSERVATION DIVISION
Wichita, Kansas

(If additional description is necessary, use BACK of this sheet)
Name of Plugging Contractor Kent Well Servicing Co., Inc.
Address Box 470, El Dorado, Kansas

STATE OF Kansas, COUNTY OF Butler, ss.
_____(employee of owner) or (owner or operator) of the above-described well, being first duly sworn on oath, says: That I have knowledge of the facts, statements, and matters herein contained and the log of the above-described well as filed and that the same are true and correct. So help me God.

(Signature) Mary Payne

(Address)

SUBSCRIBED AND SWORN TO before me this 14th day of November, 19 62

My commission expires June 18, 1963

Esther E. Phillips

Notary Public.




WELL LOG BUREAU—KANSAS GEOLOGICAL SOCIETY
508 East Murdock, Wichita, Kansas

COPY

Company **BEDELL-CATT DRILLING CO., INC.** et al SEC. 1 T. 26 R. 2E
Farm **Edson** No. 1 NE NW SE

Total Depth **2871**
Comm. **2-12-56** Comp. **2-19-56**
Shot or Treated.
Contractor **Bedell-Catt Drilling Co., Inc.**
Issued. **5-5-56**

County **Sedgwick**
KANSAS

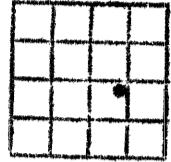

Elevation. 1343

Production. **50 BOPD**

CASING:
8 5/8 @ 93.58' w/ 85 sx cmt.
5 1/2 @ 2871'

Figures indicate Bottom of Formations.

surface hole	99
lime & shale	2121
lime	2541
lime & shale	2803
Mississippi lime	2818
lime	2831
Mississippi lime & chert	2871
Total Depth	<u>2871</u>

2359
1343
1016

SCOUT TOPS:

Lansing	2083
Kansas City	2359
Base K. C.	2522
Conglomerate shale	2795
Mississippi lime	2803

RECEIVED
STATE CORPORATION COMMISSION

NOV 15 1962

CONSERVATION DIVISION
Wichita, Kansas