

STATE OF KANSAS  
STATE CORPORATION COMMISSION


WELL PLUGGING RECORD

Give All Information Completely  
Make Required Affidavit  
Mail or Deliver Report to:  
Conservation Division  
State Corporation Commission  
800 Bitting Building  
Wichita, Kansas

OR  
FORMATION PLUGGING RECORD Strike out upper line when reporting plugging of formations.

Sedgwick County. Sec. 1 Twp. 26S Rge. 2 (E) (W)  
Location as "NE $\frac{1}{4}$ NW $\frac{1}{4}$ SW $\frac{1}{4}$ " or footage from lines. SWSENW  
Lease Owner Red Drilling Company  
Lease Name DE MOSS Well No. 1  
Office Address Box 786 - El Dorado, Kansas  
Character of Well (completed as Oil, Gas or Dry Hole) Dry hole  
Date well completed 2-17 19 57  
Application for plugging filed 2-17 19 57  
Application for plugging approved 2-17 19 57  
Plugging commenced 2-17 19 57  
Plugging completed 2-17 19 57  
Reason for abandonment of well or producing formation dry hole  
If a producing well is abandoned, date of last production 19  
Was permission obtained from the Conservation Division or its agents before plugging was commenced? yes

NORTH

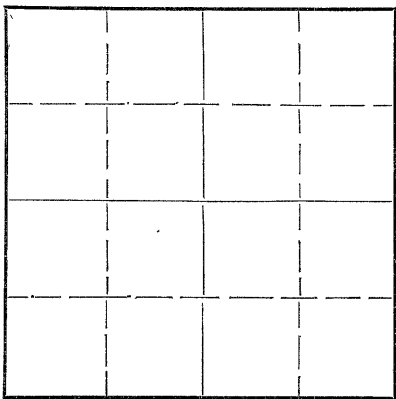

Locate well correctly on above Section Plat

Name of Conservation Agent who supervised plugging of this well Ruel E Durkee  
Producing formation \_\_\_\_\_ Depth to top \_\_\_\_\_ Bottom \_\_\_\_\_ Total Depth of Well 3246 Feet  
Show depth and thickness of all water, oil and gas formations.

OIL, GAS OR WATER RECORDS

CASING RECORD

Formation	Content	From	To	Size	Put In	Pulled Out

Describe in detail the manner in which the well was plugged, indicating where the mud fluid was placed and the method or methods used in introducing it into the hole. If cement or other plugs were used, state the character of same and depth placed, from \_\_\_\_\_ feet to \_\_\_\_\_ feet for each plug set.

Well filled with heavy mud to 120'  
Plug set at 120' 15 sacks cement thru drill pipe  
filled with heavy mud to within 15' of surface  
plug set at 15' filled to within 3' of top with cement  
pipe cut off within 3' of ground level

(If additional description is necessary, use BACK of this sheet)

Correspondence regarding this well should be addressed to Red Drilling Company  
Address Box 786, El Dorado, Kans

STATE OF Kansas COUNTY OF Butler, ss.  
O N Wilson (~~employee or owner~~) or (owner or operator) of the above-described well,

being first duly sworn on oath, says: That I have knowledge of the facts, statements, and matters herein contained and the log of the above-described well as filed and that the same are true and correct. So help me God.

(Signature) O N Wilson

O N Wilson

SUBSCRIBED AND SWORN TO before me this 19th day of February

My commission expires November 27, 1958

[Signature]  
Notary Public.

PLUGGING  
FILE SEC. 1 T. 26 R. 2E  
BOOK PAGE 142 LINE 4

RECEIVED  
FEB 20 1957  
CONSERVATION DIVISION  
WICHITA, KANSAS

# WELL LOG

Operator Red Drilling Company  
Comm 2-6-57 Comp 2-17-57  
Shot        Qts. From        ft. To        ft.  
Acidized        Gal.         
Prod. Formation         
Initial Prod.         
Elevation 1346 Cemented       

Lease De Moss Well No. 1  
Loc. SWSNW Sec. 1 Twp 26S Rge 2E  
County Sedgwick State Kansas  
Contractor Red Drilling Company

Casing Record			
Size	Ft.	Pulled	Remarks
8 5/8	120'	with 100	sx

Dry and Abandoned

## FIGURES INDICATE BOTTOM OF FORMATION

30 surface & clay  
45 sand & gravel  
125 lime & shale  
135 lime  
600 lime & shale  
700 shale & shells  
1830 shale & lime  
2115 shale & lime stks  
2368 shale & lime  
2537 Lime K C  
2725 shale & lime  
2800 shale  
2810 shale & lime  
3048 lime  
3242 shale & lime  
3246 lime

T D - 3246

PLUGGING  
FILE SEC. 1 T. 26 R. 2E  
BOOK PAGE 142 LINE 4

RECEIVED  
STATE CONSERVATION COMMISSION

FEB 20 1957  
CONSERVATION DIVISION  
Wichita, Kansas