

67


STATE OF KANSAS
STATE CORPORATION COMMISSION

Form CP-4

Give All Information Completely
Make Required Affidavit
Mail or Deliver Report to:
Conservation Division
State Corporation Commission
212 No. Market
Wichita, Kansas

WELL PLUGGING RECORD

Sedgwick County, Sec. 1 Twp. 26 Rge. 2 (E) (W)
Location as "NE/CNW/SW" or footage from lines NW NW NE
Lease Owner Acme Oil Corporation
Lease Name Bertschinger Well No. 1
Office Address 404 One Twenty Bldg., Wichita, Kansas
Character of Well (completed as Oil, Gas or Dry Hole) oil well
Date well completed 4-15-65 19
Application for plugging filed 2-28-66 19
Application for plugging approved 3-2-66 19
Plugging commenced 3-2-66 19
Plugging completed 3-4-66 19
Reason for abandonment of well or producing formation depleted

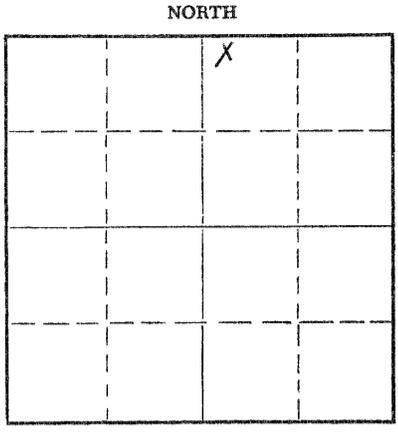

Locate well correctly on above Section Plat

If a producing well is abandoned, date of last production 19
Was permission obtained from the Conservation Division or its agents before plugging was commenced? yes

Name of Conservation Agent who supervised plugging of this well Paul Turpin
Producing formation Depth to top Bottom Total Depth of Well 2888 Feet
Show depth and thickness of all water, oil and gas formations.

OIL, GAS OR WATER RECORDS

CASING RECORD

FORMATION	CONTENT	FROM	TO	SIZE	PUT IN	PULLED OUT
				8 5/8	141	none
				5 1/2	2883	2345

Describe in detail the manner in which the well was plugged, indicating where the mud fluid was placed and the method or methods used in introducing it into the hole. If cement or other plugs were used, state the character of same and depth placed, from feet to feet for each plug set.

Fill hole with chat from 2888' to 2840' and dump 5 sacks cement.
Set 15' rock bridge from 190' to 175' and dump 20 sacks cement.
Mud hole to 30' and dump 10 sacks cement.

RECEIVED
STATE CORPORATION COMMISSION
MAR 9 1966
3-9-66
CONSERVATION DIVISION
Wichita, Kansas

(If additional description is necessary, use BACK of this sheet)
Name of Plugging Contractor Flint Engineering & Construction Co.
Address Box 950, El Dorado, Kansas

STATE OF KANSAS, COUNTY OF BUTLER, ss.

(employee of owner) or (owner or operator) of the above-described well, being first duly sworn on oath, says: That I have knowledge of the facts, statements, and matters herein contained and the log of the above-described well as filed and that the same are true and correct. So help me God.

(Signature) Paula Bowdle
El Dorado, Kansas (Address)

SUBSCRIBED AND SWORN TO before me this 8th day of March, 1966

Ronald R. Hanson
Notary Public.

My commission expires 9-27-67

9

1 - 26 - 2E

WELL LOG

COMPANY: Acme Oil Corp.
404 One Twenty Bldg.
Wichita, Kansas

COMMENCED: April 3, 1965
COMPLETED: April 15, 1965

LEASE: BERTSCHINGER #1

TOTAL DEPTH: 2190

LOCATION: NW 1/4 NE Sec. 1-26S-2E
Sedgewick County, Kansas

CONTRACTOR: Canaday Drilling Company
6427 East Kellogg
Wichita, Kansas

DIAMETER: 141 feet of 8 5/8 inch with 125 sacks cement.

FIGURES INDICATE BOTTOM OF FORMATION

0 - 70	Surface, shale and sand	2180	Shale with lime
141	shale and lime	2400	lime and shale
370	Lime with shale streaks	2420	lime
641	Lime and shale	2613	shale
1345	Shale and shells	2750	Shale with lime
1680	Shale with lime streaks	2834	Lime and shale
2190	Lime and shale	2886	Chat and lime

RECEIVED
STATE CORPORATION COMMISSION

MAR 9 1966

CONSERVATION DIVISION
Wichita, Kansas

Handwritten note:
Trans. need appropriate in mail today S.H.B.

I, Grenville E. Canaday of the CANADAY DRILLING COMPANY certify the above Well Log to be true to the best of my knowledge.

Grenville E. Canaday

Subscribed and sworn to before me, a Notary Public in and for Sedgewick County, Kansas this 13th day of April, 1965.

Notary Public, Sedgewick County, Kansas, Feb. 18, 1968.

Laveta B. Matt

Acme Oil Corporation No. 1 Bertschinger
NWNWNE Sec. 1-26S-2E
Sedgwick County, Kansas

5 1/2" casing run to 2883 feet and cemented with 170 sacks cement
and 2% gel.

Perforated at 2849 to 2854 (total of 10 holes).

Fill to 2840 + 5 SX.

190 - Bridge 15' - 20 SX

30 or 35' — 10 SX

RECEIVED
STATE CORPORATION COMMISSION

MAR 9 1966

CONSERVATION DIVISION
Wichita, Kansas