


Give All Information Completely
Make Required Affidavit
Mail or Deliver Report to:
Conservation Division
State Corporation Commission
211 No. Broadway
Wichita, Kansas

WELL PLUGGING RECORD

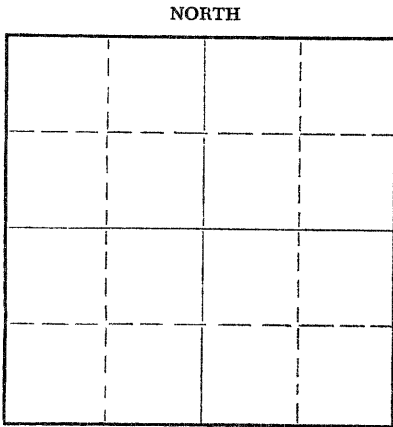

Locate well correctly on above
Section Flat

Sedgwich County. Sec. 1 Twp. 26 Rge. 2 (E) E (W)
Location as "NE/CNW/SW" or footage from lines SE SE NW
Lease Owner Red Drilling Co.
Lease Name DeMoss #2 Well No. _____
Office Address El Dorado, Kansas
Character of Well (completed as Oil, Gas or Dry Hole) _____
Date well completed 8-18-57 19_____
Application for plugging filed 10-29-57 19_____
Application for plugging approved 10-29-57 19_____
Plugging commenced 10-30-57 19_____
Plugging completed 11-2-57 19_____
Reason for abandonment of well or producing formation Dry Hole

If a producing well is abandoned, date of last production _____ 19_____
Was permission obtained from the Conservation Division or its agents before plugging was commenced? yes

Name of Conservation Agent who supervised plugging of this well Ruel Durkee
Producing formation _____ Depth to top _____ Bottom _____ Total Depth of Well 2845 Feet
Show depth and thickness of all water, oil and gas formations.

OIL, GAS OR WATER RECORDS

CASING RECORD

FORMATION	CONTENT	FROM	TO	SIZE	PUT IN	PULLED OUT
				8-5/8"	150'	none
				5-1/2"	2843'	2459'

Describe in detail the manner in which the well was plugged, indicating where the mud fluid was placed and the method or methods used in introducing it into the hole. If cement or other plugs were used, state the character of same and depth placed, from _____ feet to _____ feet for each plug set.

Checked the hole to 2808' and found it open. filled w/sand to 2790' and ran 6 sacks of cement. Pulled 5 1/2" casing. Mudded the hole and bailed down to 140', set a 10' rock bridge and ran 15 sacks of cement. Mudded the hole to 25', set a 10' rock bridge and ran 5 sacks of cement to base of cellar.

11-7-57
NOV 7 1957

(If additional description is necessary, use BACK of this sheet)
Name of Plugging Contractor West Supply Co., Inc.
Address Chase, Kansas


STATE OF Kansas, COUNTY OF Butler, ss: O. N. Wilson (employee of owner) or (owner or operator) of the above-described well, being first duly sworn on oath, says: That I have knowledge of the facts, statements, and matters herein contained and the log of the above-described well as filed and that the same are true and correct. So help me God.

(Signature) By: O. N. Wilson
Box 786, El Dorado, Kansas (Address)

SUBSCRIBED AND SWORN to before me this 6th day of November, 1957

Edith S. Riggall
Notary Public.

My commission expires March 3, 1959.

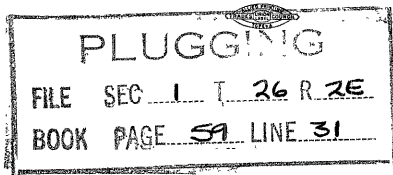

WELL LOG

Operator RED DRILLING COMPANY
 Comm 8-11-57 Comp 8-18-57
 Shot _____ Qts. From _____ ft. To _____ ft.
 Acidized _____ Gal. _____
 Prod. Formation _____
 Initial Prod. _____
 Elevation DF 1342' GL 1340'

Lease DeMoss Well No. 2
 Loc SE SE NW Sec 1 Twp 26S Rge 2E
 County Sedgwick State Kansas
 Contractor RED DRILLING COMPANY

Casing Record

Size	Ft.	Pulled	Remarks
<u>8 5/8"</u>	<u>153</u>	<u>W/120 sacks</u>	
<u>5 1/2"</u>	<u>2841</u>	<u>W/60 sacks</u>	

Cemented
Cemented

FIGURES INDICATE BOTTOM OF FORMATION

120	shale & lime
400	lime & shale
460	shale & lime
705	shale
1405	shale & shells
1660	shale & lime
2140	lime & shale
2255	lime
2369	lime & shale
2529	lime
2843	lime & shale

Total Depth 2843'

This is to certify that the above log is true and correct.

RED DRILLING COMPANY

BY O. N. Wilson
O. N. Wilson

Subscribed and sworn to before me this 22nd of August, 1957

My commission expires:
March 3, 1959

Edith L. Russell
Notary Public

PLUGGING
 FILE SEC 1 T 26 N 2E
 BOOK PAGE 59 LINE 31