


Give All Information Completely  
Make Required Affidavit  
Mail or Deliver Report to:  
Conservation Division  
State Corporation Commission  
211 No. Broadway  
Wichita, Kansas

WELL PLUGGING RECORD

NORTH

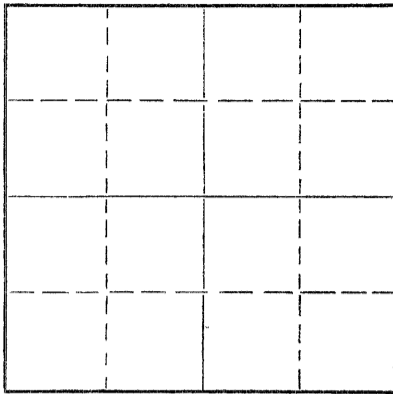

Locate well correctly on above  
Section Plat

Sedgwick County. Sec. 1 Twp. 26S Rge. 2 (E) ~~XXXXXX~~  
Location as "NE/CNW/SW" or footage from lines SW SE NE  
Lease Owner Lee Phillips Oil Company  
Lease Name Berchsinger Well No. 1  
Office Address 1407 Union National Bank Bldg., Wichita 2, Ks.  
Character of Well (completed as Oil, Gas or Dry Hole) Dry Hole  
Date well completed July 13 1956  
Application for plugging filed " 1956  
Application for plugging approved " 1956  
Plugging commenced " 1956  
Plugging completed " 1956  
Reason for abandonment of well or producing formation Dry Hole

If a producing well is abandoned, date of last production \_\_\_\_\_ 19\_\_\_\_  
Was permission obtained from the Conservation Division or its agents before plugging was commenced? Yes

Name of Conservation Agent who supervised plugging of this well Ruel Durkee, Box 597, McPherson, Kansas  
Producing formation \_\_\_\_\_ Depth to top \_\_\_\_\_ Bottom \_\_\_\_\_ Total Depth of Well 2386 Feet  
Show depth and thickness of all water, oil and gas formations.

OIL, GAS OR WATER RECORDS

CASING RECORD

FORMATION	CONTENT	FROM	TO	SIZE	PUT IN	PULLED OUT
				8 5/8	97	None

Describe in detail the manner in which the well was plugged, indicating where the mud fluid was placed and the method or methods used in introducing it into the hole. If cement or other plugs were used, state the character of same and depth placed, from \_\_\_\_\_ feet to \_\_\_\_\_ feet for each plug set.

Built solid bridge 97' cemented with 15 sx cement  
Solid bridge at 20' cemented with 5 sx cement

(If additional description is necessary, use BACK of this sheet)  
Name of Plugging Contractor Bedell-Catt Drilling Co., Inc.  
Address 605 Union Nat'l Bank Bldg., Wichita 2, Kansas

STATE OF Kansas, COUNTY OF Sedgwick, ss.  
Corb S. Bedell (employee of owner) or (owner or operator) of the above-described well, being first duly sworn on oath, says: That I have knowledge of the facts, statements, and matters herein contained and the log of the above-described well as filed and that the same are true and correct. So help me God.

(Signature) BEDELL-CATT DRILLING CO., INC.  
By: Corb S. Bedell  
(Address)

SUBSCRIBED AND SWORN TO before me this 16th day of July, 19 56  
Francis J. Hebbes  
Notary Public.

My commission expires March 18, 1958

PLUGGING  
FILE SEC L T 26R 2E  
BOOK PAGE 80 LINE 34

7-17-56

DRILLING LOG

Company: Lee Phillips Oil Company  
1407 Union Nat'l Bank Bldg.,  
Wichita 2, Kansas

Lease: Berchsinger

Well: #1

Location: SW SE NE of Section 1, Township 26 South, Range 2 East,  
Sedgwick County, Kansas

Contractor: Bedell-Catt Drilling Co., Inc.  
605 Union Nat'l Bank Bldg.,  
Wichita 2, Kansas

Date Comm: July 3, 1956

Date Compl: July 13, 1956

T.D. 2886'

Production: D & A

Casing: 97' of 10" casing w/ 80 sx cement

Figures Indicate the Bottom of Formation


0-98 Surface hole  
2408 Shale & lime  
2495 Lime  
2840 Lime & shale  
2886 Chert & lime  
2886' T.D.

I certify the above to be true and correct to the best of  
my knowledge and belief.

BEDELL-CATT DRILLING CO., INC.

By   
Corb S. Bedell

Subscribed and sworn before me this 16th day of July, 1956.

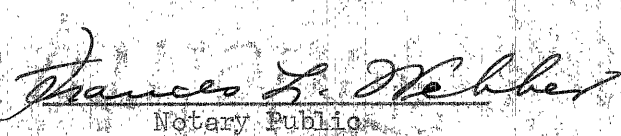  
Notary Public

My Commission Expires:

March 18, 1958

