


STATE OF KANSAS  
STATE CORPORATION COMMISSION

Give All Information Completely  
Make Required Affidavit  
Mail or Deliver Report to:  
Conservation Division  
State Corporation Commission  
211 No. Broadway  
Wichita, Kansas

WELL PLUGGING RECORD

Sedgwick County. Sec. 1 Twp. 26S Rge. 2 (E) E (W)  
Location as "NE/CNW/SW" or footage from lines se/se/sw  
Lease Owner Aurora Gasoline Company  
Lease Name Elliot # 2 Well No. \_\_\_\_\_  
Office Address Parrish Hotel, Pratt, Kansas  
Character of Well (completed as Oil, Gas or Dry Hole) oil  
Date well completed 3-13-57 19\_\_\_\_  
Application for plugging filed 2-12-59 19\_\_\_\_  
Application for plugging approved \_\_\_\_\_ file # 15-28 19\_\_\_\_  
Plugging commenced 2-17-59 7:30 am 19\_\_\_\_  
Plugging completed 2-19-59 3:30 pm 19\_\_\_\_  
Reason for abandonment of well or producing formation to much water for amount of oil pumped  
If a producing well is abandoned, date of last production november 1958 19\_\_\_\_  
Was permission obtained from the Conservation Division or its agents before plugging was commenced? yes

NORTH

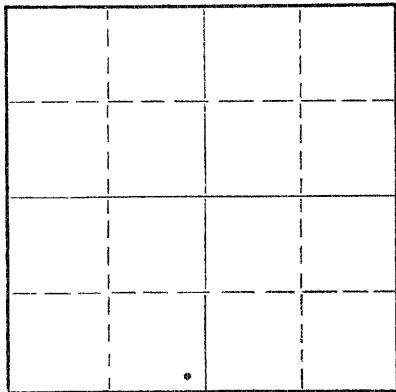

Locate well correctly on above Section Plat

Name of Conservation Agent who supervised plugging of this well Lee Guthrie  
Producing formation Lime Depth to top 2802 Bottom 2808 Total Depth of Well 2880 Feet  
Show depth and thickness of all water, oil and gas formations.

OIL, GAS OR WATER RECORDS

CASING RECORD

FORMATION	CONTENT	FROM	TO	SIZE	PUT IN	PULLED OUT
				8 5/8"	103'	cemented
				5 1/2"	2880'	2423'

Describe in detail the manner in which the well was plugged, indicating where the mud fluid was placed and the method or methods used in introducing it into the hole. If cement or other plugs were used, state the character of same and depth placed, from \_\_\_\_\_ feet to \_\_\_\_\_ feet for each plug set.

2805' - 5 sacks cement

160' = 10 ft rock bridge - 20 sacks cement - dumped dry mudded to 40'

40' - 5 ft rock bridge - 10 sacks cement - filled to top of surface welded plate on top of surface pipe

Pipe was set through & cement was drilled out to 2847'

Well was filled up to 2805' - cemented was dumped there

Pipe was perforated 2802' - 2808'

(If additional description is necessary, use BACK of this sheet)  
Name of Plugging Contractor Kent Well Servicing company # 394  
Address Box 667 El Dorado, Kansas

STATE OF Kansas COUNTY OF Butler ss.  
C. D. Payne (employee of owner) or (owner or operator) of the above-described well, being first duly sworn on oath, says: That I have knowledge of the facts, statements, and matters herein contained and the log of the above-described well as filed and that the same are true and correct. So help me God.

(Signature) C. D. Payne  
Box 667 El Dorado, Kansas (Address)

SUBSCRIBED AND SWORN to before me this 27th day of February 1959  
Velma H. Stebbins Notary Public.

My commission expires 3-14-1960

PLUGGING  
FILE SEC. 1 T. 26 R. 2E  
BOOK PAGE 15 LINE 29

FEB 28 1959  
2-28-59  
CONSERVATION DIVISION  
Wichita, Kansas