

15-173-01908-00-00

STATE OF KANSAS
STATE CORPORATION COMMISSION


We also need a log on this well

Form CP-4

Give All Information Completely
Make Required Affidavit
Mail or Deliver Report to:
Conservation Division
State Corporation Commission
211 No. Broadway
Wichita, Kansas

WELL PLUGGING RECORD

NORTH

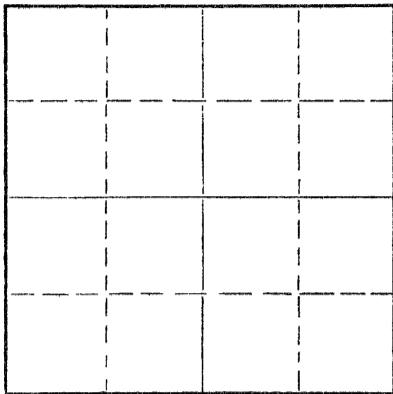

Locate well correctly on above
Section Plat

Sedgwick County. Sec. 1 Twp. 26 Rge. 2E (E) 11(W)

Location as "NE/CNW/SW" or footage from lines SE SW SW

Lease Owner Warren R. Winne Oil Company

Lease Name Elliot Well No. 1

Office Address 5503 E. Kellogg - Wichita, Kansas.

Character of Well (completed as Oil, Gas or Dry Hole) OIL

Date well completed _____ 19 _____

Application for plugging filed _____ 19 _____

Application for plugging approved 3/8/61 19 _____

Plugging commenced 3/8/61 19 _____

Plugging completed 3/8/61 19 _____

Reason for abandonment of well or producing formation _____

If a producing well is abandoned, date of last production _____ 19 _____

Was permission obtained from the Conservation Division or its agents before plugging was commenced? Yes

Name of Conservation Agent who supervised plugging of this well Lee Guthrie

Producing formation _____ Depth to top _____ Bottom _____ Total Depth of Well 2885' Feet

Show depth and thickness of all water, oil and gas formations.

OIL, GAS OR WATER RECORDS

CASING RECORD

| FORMATION | CONTENT | FROM | TO | SIZE | PUT IN | PULLED OUT |
|-----------|---------|------|----|------|--------|------------|
| | | | | | | |
| | | | | | | |
Describe in detail the manner in which the well was plugged, indicating where the mud fluid was placed and the method or methods used in introducing it into the hole. If cement or other plugs were used, state the character of same and depth placed, from _____ feet to _____ feet for each plug set.

200' 8t/8" surface pipe set. Cement circulated 2883
4 1/2" pipe set with 100 sacks cement. Top perforation
at 2818', hole filled to 2800' with gravel and 4 sacks
cement at 180' set 20" Rock Bridge and 15 sacks cement.
Mud to 35' set 5' Rock Bridge and 10 sacks cement which
recovered 2300' 4 1/2" pipe

RECEIVED
STATE CORPORATION COMMISSION

SEP 17 1963
9-17-63
CONSERVATION DIVISION
Wichita, Kansas

(If additional description is necessary, use BACK of this sheet)
Name of Plugging Contractor B. & G. Well Service
Address 2001 S. Main - Winfield, Kansas.

STATE OF Kansas, COUNTY OF Sedgwick, ss.

_____ (employee of owner) or (owner or operator) of the above-described well, being first duly sworn on oath, says: That I have knowledge of the facts, statements, and matters herein contained and the log of the above-described well as filed and that the same are true and correct. So help me God.

(Signature) Warren R. Winne
5503 E. Kellogg
(Address)

SUBSCRIBED AND SWORN TO before me this 13 day of September, 1963

My commission expires 6-14-64 _____
Notary Public.



WELL LOG BUREAU--KANSAS GEOLOGICAL SOCIETY
 508 East Murdock, Wichita, Kansas




Company- WANDA M. WINNE
 Farm- Elliott No. 1

SEC. 1 T. 26 R. 2
 SE SW SW 1-26-2E

Total Depth. 2885'
 Comm. 2-7-61 Comp. 3-17-61
 Shot or treated.
 Contractor. Beverly Oil & Gas
 Issued. 9-1-62

County Sedgwick
 KANSAS

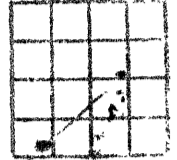

CASING:
 8" 130'
 5" 2883'

Elevation. 1348' RE

Production. DRY

Figures Indicate Bottom of Formations.

COMPLETE DRILLERS LOG NOT AVAILABLE.

TOES: SCOUT
 Lansing 2156
 Kansas City 2381
 B/Kansas City 2545
 Mississippi 2821

2381
 1348

 1033