

This form shall be filed in duplicate with the Kansas Corporation Commission, 200 Colorado Derby Building, Wichita, Kansas 67202, within ten days after the completion of the well, regardless of how the well was completed.

Attach separate letter of request if the information is to be held confidential. If confidential, only file one copy. Information on side one will be of public record and side two will then be held confidential.

Circle one: Oil, Gas, Dry, SWD, OWVO, Injection. Type and complete ALL sections. Applications must be filed for dual completion, commingling, SWD and injection, T.A.

Attach wireline logs (i.e. electrical log, sonic log, gamma ray neutron log, etc.). KCC # (316) 263-3238. (Rules 82-2-105 & 82-2-125)

00-01

OPERATOR ENERGY THREE, INC.

API NO. 15-065-21,271-X

ADDRESS P. O. Box 1505

COUNTY GRAHAM

GREAT BEND, KANSAS 67530

FIELD GETTYSBURG N (LANS)

**CONTACT PERSON R. D. STANDLEE

PROD. FORMATION

PHONE AC 316-792-5968

LEASE JUSTUS-WYATT

PURCHASER

WELL NO. 1 (WASHDOWN)

ADDRESS

WELL LOCATION SE SE SE

DRILLING BIG THREE DRILLING, INC.

330 Ft. from SOUTH Line and

CONTRACTOR ADDRESS P. O. Box 52

330 Ft. from EAST Line of


GORHAM, KANSAS 67640

the SE/4SEC. 6 TWP. 8S RGE. 23W

PLUGGING SUN OILWELL CEMENTING

WELL PLAT

CONTRACTOR ADDRESS GREAT BEND, KANSAS

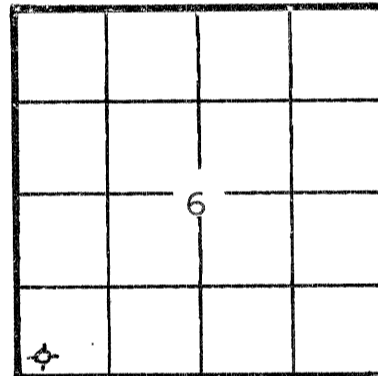

KCC KGS (Office Use)

TOTAL DEPTH 3800 PBD

WASHDOWN / SWD DATE 5-2-82 DATE COMPLETED 5-4-82

ELEV: GR 2296 DF KB 2301

DRILLED WITH (CABLE) (ROTARY) (AIR) TOOLS

Amount of surface pipe set and cemented 254 DV Tool Used? NO

AFFIDAVIT

STATE OF KANSAS, COUNTY OF GRAHAM SS, I,

R. D. STANDLEE OF LAWFUL AGE, BEING FIRST DULY SWORN UPON HIS OATH, DEPOSES THAT HE IS EXECUTIVE VICE-PRES. (XXX)(OF) ENERGY THREE, INC.

OPERATOR OF THE JUSTUS-WYATT LEASE, AND IS DULY AUTHORIZED TO MAKE THIS AFFIDAVIT FOR AND ON THE BEHALF OF SAID OPERATOR, THAT WELL NO. 1 ON SAID LEASE HAS BEEN COMPLETED AS OF THE 4TH DAY OF MAY, 19 82, AND THAT ALL INFORMATION ENTERED HEREIN WITH RESPECT TO SAID WELL IS TRUE AND CORRECT.

FURTHER AFFIANT SAITH NOT.

(S) [Signature]

SUBSCRIBED AND SWORN BEFORE ME THIS 28TH DAY OF MAY, 19 82.



[Signature] NOTARY PUBLIC STATE OF KANSAS

MY COMMISSION EXPIRES: DECEMBER 15, 1984

RECEIVED JUN 25 1982 CONSERVATION DIVISION Wichita, Kansas

**The person who can be reached by phone regarding any questions concerning this information. Within 45 days of completion, a witnessed initial test by the Commission is required if the well produces more than 25 BOPD or is located in a Basic

SIDE TWO

WELL LOG

Show all important zones of porosity and contents thereof; cored intervals, and all drill-stem tests, including depth interval tested, cushion used, time tool open, flowing and shut-in pressures, and recoveries.

SHOW GEOLOGICAL MARKERS, LOGS RUN, OR OTHER DESCRIPTIVE INFORMATION.

FORMATION DESCRIPTION; CONTENTS, ETC.	TOP	BOTTOM	NAME	DEPTH
SURFACE HOLE	-0-	256	PETRO-LOG	RAN OPEN HOLE
SAND & SHALE	256	1830	LOG ON 5-	3-82 FROM
SHALE & SAND	1830	1952	3800' TO	-0-
ANHYDRITE	1952	1984		
SHALE & SAND	1984	2480	ELEC. LOG	TOPS
SHALE & LIME	2480	3570		
LIME	3570	3745		
SHALE & LIME	3745	3800	TOPEKA	3312
		RTD	HEEBNER	3523
			TORONTO	3547
			LANSING-KC	3564
			MUNCIE CREEK	3675
			KC BASE	3771

Report of all strings set — surface, intermediate, production, etc. **CASING RECORD** (New) or (Used)

Purpose of string	Size hole drilled	Size casing set (in O.D.)	Weight lbs/ft.	Setting depth	Type cement	Sacks	Type and percent additives
SURFACE	12 1/4	8 5/8	20 #	254	COMMON	185	3 % C.C. 2 % GEL

LINER RECORD

PERFORATION RECORD

Top, ft.	Bottom, ft.	Sacks cement	Shots per ft.	Size & type	Depth interval

TUBING RECORD

Size	Setting depth	Packer set at

ACID, FRACTURE, SHOT, CEMENT SQUEEZE RECORD

Amount and kind of material used	Depth interval treated

Date of first production	Producing method (flowing, pumping, gas lift, etc.)	Gravity
--------------------------	---	---------

DRY HOLE

RATE OF PRODUCTION PER 24 HOURS	Oil bbls.	Gas MCF	Water %	Gas-oil ratio bbls.	CFPB
---------------------------------	-----------	---------	---------	---------------------	------

Disposition of gas (vented, used on lease or sold)

Perforations