

This form shall be filed in duplicate with the Kansas Corporation Commission, 200 Colorado Derby Building, Wichita, Kansas 67202, within ten days after the completion of the well, regardless of how the well was completed.

Attach separate letter of request if the information is to be held confidential. If confidential, only file one copy. Information on side one will be of public record and side two will then be held confidential.

Circle one: Oil, Gas, Dry, SWD OWWO, Injection. Type and complete ALL sections. Applications must be filed for dual completion, commingling, SWD and injection, T.A.

Attach wireline logs (i.e. electrical log, sonic log, gamma ray neutron log, etc.). KCC # (316) 263-3238. (Rules 82-2-105 & 82-2-125)

15-065-00368-00-01

OPERATOR A. Scott Ritchie

API NO. 15, - OWWO

ADDRESS 125 N. Market, Suite 950
Wichita, Kansas 67202

COUNTY Graham

**CONTACT PERSON A. Scott Ritchie
PHONE 267-4375

FIELD Montgomery
Disposal
FORMATION Cedar Hills

PURCHASER, None

LEASE Montgomery Area SWDW

ADDRESS

WELL NO. 1

DRILLING Murfin Drilling Company
CONTRACTOR
ADDRESS 617 Union Center
Wichita, Kansas 67202

WELL LOCATION NW NW NE


330 Ft. from North Line and

330 Ft. from West Line of

the NE/4 SEC. 8 TWP. 8S RGE. 23W

PLUGGING None
CONTRACTOR
ADDRESS

WELL PLAT

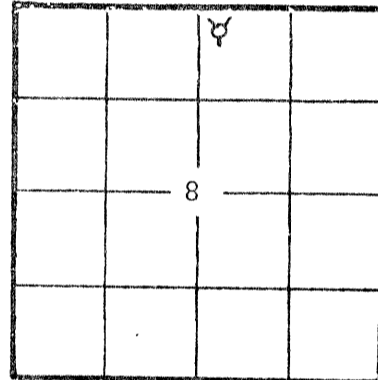

KCC
KGS
(Office Use)

TOTAL DEPTH 1885' PBD

SPUD DATE 4/12/82 DATE COMPLETED 4/14/82

ELEV: GR 2225'est.DF RB 2230'

DRILLED WITH (CORK) (ROTARY) (A) TOOLS

Amount of surface pipe set and cemented 165' DV Tool Used? no

AFFIDAVIT

STATE OF Kansas, COUNTY OF Sedgwick SS, I,

A. Scott Ritchie OF LAWFUL AGE, BEING FIRST DULY SWORN UPON HIS OATH

DEPOSES THAT HE IS (CORK) OPERATOR OF THE Montgomery Area SWDW LEASE, AND IS DULY AUTHORIZED TO MAKE THIS AFFIDAVIT FOR AND ON THE BEHALF OF SAID OPERATOR, THAT WELL NO. 1 SAID LEASE HAS BEEN COMPLETED AS OF THE 14th DAY OF April, 19 82, AND THAT ALL INFORMATION ENTERED HEREIN WITH RESPECT TO SAID WELL IS TRUE AND CORRECT. FURTHER AFFIANT SAITH NOT.

STATE OF KANSAS RECEIVED
MAY 21 1982
CONSERVATION DIVISION
Wichita, Kansas

(S) [Signature]

SUBSCRIBED AND SWORN BEFORE ME THIS 5th DAY OF May, 19 82.

CAROLYN S. HOLDEMAN
STATE NOTARY PUBLIC
Sedgwick County, Kansas
My Appointment Expires 10/5/82

[Signature]
NOTARY PUBLIC

**The person who can be reached by phone regarding any questions concerning this information. Within 45 days of completion, a witnessed initial test by the Commission is required if the well produces more than 25 BOPD or is located in a Basic Order Pool.

SIDE TWO

WELL LOG

Show all important zones of porosity and contents thereof; cored intervals, and all drill-stem tests, including depth interval tested, cushion used, time tool open, flowing and shut-in pressures, and recoveries.

SHOW GEOLOGICAL MARKERS, LOGS RUN, OR OTHER DESCRIPTIVE INFORMATION.

FORMATION DESCRIPTION, CONTENTS, ETC.	TOP	BOTTOM	NAME	DEPTH
ELECTRIC LOG TOPS				
B/Ft. Hays Ls. 356' (+1869)				
Dakota 733' (+1497)				
Cedar Hills 1394' (+ 836)				
Anhydrite 1876' (+ 354)				
<p style="font-size: 24px; font-family: cursive;">Additional information</p> <p style="font-size: 18px; font-family: cursive;">↓ Tubing & packer set on May 19, 1982.</p>				

Report of all strings set — surface, intermediate, production, etc. CASING RECORD (New) or (Used).

Purpose of string	Size hole drilled	Size casing set (in O.D.)	Weight lbs/ft.	Setting depth	Type cement	Sacks	Type and percent additives
Surface		8-5/8"		165'		100	
Production	7-7/8"	4 1/2"	10.5#	1885'	common	530	

LINER RECORD

PERFORATION RECORD

Top, ft.	Bottom, ft.	Sacks cement	Shots per ft.	Size & type	Depth interval
			1	strip jet	1600'-1630'

TUBING RECORD

Non-corrosive fluid from 1495' to surface.
 Size 2-3/8" Setting depth 1495' Packer set at surface. 1495'

ACID, FRACTURE, SHOT, CEMENT SQUEEZE RECORD

Amount and kind of material used	Depth interval treated

Date of first production	Producing method (flowing, pumping, gas lift, etc.)	Gravity
--------------------------	---	---------

RATE OF PRODUCTION PER 24 HOURS	Oil bbls.	Gas MCF	Water %	Gas-oil ratio bbls.	CFPB
---------------------------------	-----------	---------	---------	---------------------	------

Disposition of gas (vented, used on lease or sold)

Perforations