

STATE OF KANSAS  
STATE CORPORATION COMMISSION

WELL PLUGGING RECORD


OR

FORMATION PLUGGING RECORD

Strike out upper line when reporting plugging off formations.

Give All Information Completely  
Make Required Affidavit  
Mail or Deliver Report to:  
Conservation Division  
State Corporation Commission  
800 Bittling Building  
Wichita, Kansas

NORTH

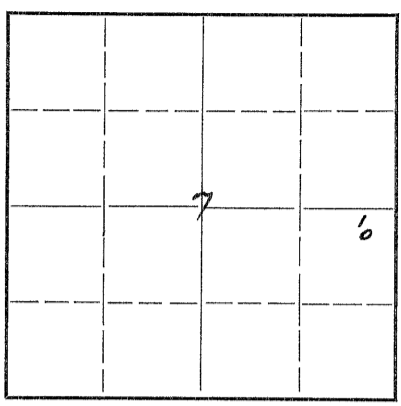

Locate well correctly on above Section Plat

Graham County. Sec. 7 Twp. 8 Rge. (E) 23 (W)  
Location as "NE 1/4 NW 1/4 SW 1/4" or footage from lines 330' S. 330' W from E 1/4 Corner  
Lease Owner Cities Service Oil Company  
Lease Name Emery Well No. 1  
Office Address Bartlesville, Oklahoma.  
Character of Well (completed as Oil, Gas or Dry Hole) Dry Hole  
Date well completed 8/27/42 19.  
Application for plugging filed 8/27/42 19.  
Application for plugging approved 8/27/42 19.  
Plugging commenced 8/27/42 19.  
Plugging completed 8/27/42 19.  
Reason for abandonment of well or producing formation Wt/ Dry

If a producing well is abandoned, date of last production 19.  
Was permission obtained from the Conservation Division or its agents before plugging was commenced? Yes

Name of Conservation Agent who supervised plugging of this well Mr. C.T. Alexander  
Producing formation Arbuckle Lime Depth to top 3979' Bottom 4013' Total Depth of Well 4008' Feet  
Show depth and thickness of all water, oil and gas formations.

OIL, GAS OR WATER RECORDS

CASING RECORD

Formation	Content	From	To	Size	Put In	Pulled Out
<u>Arbuckle Lime</u>	<u>Dry</u>			<u>85/8"</u>	<u>230'</u>	<u>None</u>

Describe in detail the manner in which the well was plugged, indicating where the mud fluid was placed and the method or methods used in introducing it into the hold. If cement or other plugs were used, state the character of same and depth placed, from \_\_\_\_\_ feet to \_\_\_\_\_ feet for each plug set.  
Filled with mud from TD <sup>4013'</sup> 4008' to 230' set wood plug dumped 15 sacks cement mud to 35' set wood plug dumped 10 sacks cement mud & dirt to surface.

*pd*  
*9/21/42*  
*Ho*

RECORDED  
INDEXED  
7 8 23W  
48 24

*10-16-1942*

(If additional description is necessary, use BACK of this sheet)

Correspondence regarding this well should be addressed to Mr. R.C. Hauber  
Address Cities Service Oil Co. Great Bend, Kansas.

STATE OF Kansas, COUNTY OF Barton  
Mr. J.A. Cleverley (employee of owner) or (owner or operator) of the above-described well, being first duly sworn on oath, says: That I have knowledge of the facts, statements, and matters herein contained and the log of the above-described well as filed and that the same are true and correct. So help me God.

(Signature) *J.A. Cleverley*

Cities Service Oil Co. Russell, Kansas.  
(Address)

SUBSCRIBED AND SWORN TO before me this 12 day of Sept, 19 42

*C. Botwinby*  
Notary Public.

My Commission Expires Sept. 26, 1942

My commission expires \_\_\_\_\_

15-065-02703-00-00

Geol. '63 3M 4-40

WELL RECORD

Company Cities Service Oil Co. Well No. 1 Farm inery  
 Location 330' south and 330' west of E/4 Corner Sec. 7 T. 8 R. 23W  
 Elevation 2227 County Graham State Kansas  
 Drig. Comm. August 11, 1942 Contractor Corbett-Harbour Drilling Company  
 Drig. Comp. August 26, 1942 Acid None  
 T. D. 4013' Initial Prod. Dry - Plugged and Abandoned

CASING RECORD:

8-5/8" x 330' con. 115 ex Ash Grove sand 200# C. C.

FORMATION RECORD:

Surface clay & sand	0-65
shale & shells	950
shale, shells & sand	1240
anhydrite	1310
red rock	1440
red bed & sand	1650
red bed, sand & shale	1840
red bed & shale	1885
anhydrite and shale	1920
shale & shells	2520
lime & shale	2590
hard sand & shale	2635
shale & lime	2750
lime & shale	2815
sandy lime & shale	2865
lime & shale	3055
shale & lime	3090
shale & shells	3140
lime	3470
lime & chert	3501
lime cherty	3548
lime	3715
lime & shale	3757
shale & shells	3780
shale & lime	3843
shale & shells	3873
shale & lime	3884
conglomerate	3910
lime	3918
shale & sand	3936
cherty conglomerate	3946
shale & lime	3948
cherty conglomerate	3972
conglomerate	3990
Arbuckle lime	4013 T. D.

Top Lansing	3497'
Arbuckle	3779'
Penetration	34'
Total Depth	4013'

Syfo:	500'	0°
	1000'	0°
	1500'	0°
	2500'	0° 2000' 0°
	2750'	0°
	3000'	0°
	3250'	0°

WELL SEC-7 8 23W  
 BOOK PAGE 48 LINE 24

10-16-1942