

Give All Information Completely
Make Required Affidavit
Mail or Deliver Report to
Conservation Division
State Corporation Comm.
200 Colorado Derby Bldg.
202 W. 1st St.
Wichita, KS 67202

WELL PLUGGING RECORD

Graham County Sec. 7 Twp. 8s Rge. 23 E/W
Location as "NE/CNW/SW" or footage from lines _____
C N/2 NE NE

Lease Owner Griggs Oil, Inc.
Lease Name Montgomery Well No. #2
Office Address 1625 KSB&T Bldg. Wichita, Ks 67202

Character of Well (Completed as Oil, Gas or Dry Hole) _____
Dry Hole

Date Well completed November 25 1981

Application for plugging filed November 25 1981

Application for plugging approved November 25 1981

Plugging commenced 1:00 A.M. November 25 1981

Plugging completed 3:00 A.M. November 25 1981


Reason for abandonment of well or producing formation _____
No Commercial Production

If a producing well is abandoned, date of last production _____
19 _____

Was permission obtained from the Conservation Division or its agents before plugging was commenced? Yes

Name of Conservation Agent who supervised plugging of this well Gil Balthazor
Producing formation _____ Depth to top _____ Bottom _____ Tl. Depth of Well _____
Show depth and thickness of all water, oil and gas formations.

locate well correctly
on above
Section Plot

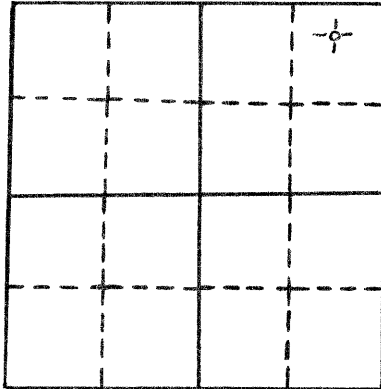

OIL, GAS OR WATER RECORDS

CASING RECORD

FORMATION	CONTENT	FROM	TO	SIZE	PUT IN	PULLED OUT
Surface Casing	common	0'	276.99'	8 5/8"	276.99'	0'

Describe in detail the manner in which the well was plugged, indicating where the mud fluid was placed and the method or methods used in introducing it into the hold. If cement or other plugs were used, state the character of same and depth placed, from _____ feet to _____ feet for each plug set.

Plug #1 990' with 70sxs

Plug #2 270' with 40sxs

Plug #3 40' with 10sxs

5sxs in rathole

Total---125sxs 50-50pos 4%gel 3%cc

(If additional description is necessary, use BACK of this sheet)

Name of Plugging Contractor Pioneer Drilling Co, Inc.
308 West Mill Plainville, KS 67663

STATE OF Kansas COUNTY OF Sedgwick, ss.

Jack S. Griggs (employee of owner) or (owner or operator) of the above described well, being first duly sworn on oath, says: That I have knowledge of the facts, statements, and matters herein contained and the log of the above described well is filed and that the same are true and correct. So help me God.



(Signature) Jack S. Griggs

(Address) 1625 KSB&T Bldg.
Wichita, Ks. 67202

SUBSCRIBED AND SWORN TO before me this 2nd day of December, 1981

My commission expires April 4, 1984

Roxana L. Miller
Notary Public

