


STATE OF KANSAS
STATE CORPORATION COMMISSION

WELL PLUGGING RECORD

Give All Information Completely
Make Required Affidavit
Mail or Deliver Report to:
Conservation Division
State Corporation Commission
800 Bitting Building
Wichita, Kansas

NORTH

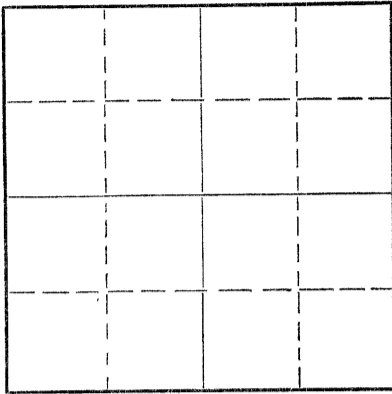

Locate well correctly on above
Section Plat

Graham County. Sec. 8 Twp. 8S Rge. (E) 23(W)

Location as "NE/CNW%SW%" or footage from lines. NW NW NE

Lease Owner Jones, Shelburne & Farmer, Inc.

Lease Name Montgomery Well No. 1

Office Address Russell, Kansas

Character of Well (completed as Oil, Gas or Dry Hole) Dry

Date well completed 7-20 1953

Application for plugging filed 7-20 1953

Application for plugging approved 7-20 1953

Plugging commenced 7-20 1953

Plugging completed 7-20 1953

Reason for abandonment of well or producing formation Dry

If a producing well is abandoned, date of last production. Never produced 19

Was permission obtained from the Conservation Division or its agents before plugging was commenced? yes

Name of Conservation Agent who supervised plugging of this well Elden Petty

Producing formation Depth to top Bottom Total Depth of Well 3915 Feet

Show depth and thickness of all water, oil and gas formations.

OIL, GAS OR WATER RECORDS

CASING RECORD

FORMATION	CONTENT	FROM	TO	SIZE	PUT IN	PULLED OUT
				8 5/8	165'	None
				5 1/2	3805	3020'

Describe in detail the manner in which the well was plugged, indicating where the mud fluid was placed and the method or methods used in introducing it into the hole. If cement or other plugs were used, state the character of same and depth placed, from feet to feet for each plug set.

1. Rock bridged set at 3610'
2. 4 sacks cement mixed and dumped on top of bridge with dump bailer
3. Shot off pipe at 3250-could not circulate
4. Shot off pipe at 3020-circulated-11" stretch
5. Spotted oil and pulled pipe
6. Mudded hole to 160'
7. Set rock bridge at 160'
8. Mixed 25 sacks cement and dumped on top of bridge
9. Mudded hole to 40' and set bridge
10. Mixed 10 sacks cement and filled to top

(If additional description is necessary, use BACK of this sheet)

Name of Plugging Contractor Forbes Casing Pulling Company

Address Great Bend, Kansas

STATE OF Kansas, COUNTY OF Russell, ss.

John O. Farmer (employee of owner) or (owner or operator) of the above-described

well, being first duly sworn on oath, says: That I have knowledge of the facts, statements, and matters herein contained and the log of the above-described well as filed and that the same are true and correct. So help me God.

(Signature) John O. Farmer
Russell, Kansas (Address)

SUBSCRIBED AND SWORN TO before me this 31st day of July, 1953

My commission expires April 23, 1956

Bonnie Berryhill
Notary Public.

RECEIVED
STATE CORPORATION COMMISSION

AUG - 3 1953
8-3-1953
CONSERVATION DIVISION
Wichita, Kansas

