


STATE OF KANSAS
STATE CORPORATION COMMISSION

15-065-02466-00-00
WELL PLUGGING RECORD

Give All Information Completely
Make Required Affidavit
Mail or Deliver Report to:
Conservation Division
State Corporation Commission
800 Bitting Building
Wichita, Kansas

NORTH

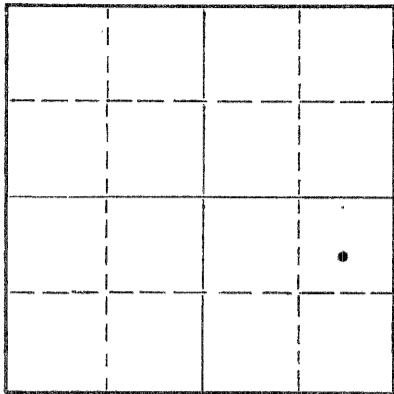

Locate well correctly on above
Section Plat

Graham County. Sec. 17 Twp. 8S Rge. 23 (W)
Location as "NE/CNW/SW" or footage from lines C-NE/NE/SE
Lease Owner Amerada Petroleum Corporation
Lease Name R.C. Bethell Well No. 1
Office Address Box 197, Great Bend, Kansas
Character of Well (completed as Oil, Gas or Dry Hole) Dry Hole
Date well completed 1-5- 19 58
Application for plugging filed Yes 19
Application for plugging approved Yes 19
Plugging commenced 1-18- 19 58
Plugging completed 1-24- 19 58
Reason for abandonment of well or producing formation Dry Hole

If a producing well is abandoned, date of last production - 19 -
Was permission obtained from the Conservation Division or its agents before plugging was commenced? Yes

Name of Conservation Agent who supervised plugging of this well A.D. Fabricius
Producing formation _____ Depth to top _____ Bottom _____ Total Depth of Well 3685 Feet
Show depth and thickness of all water, oil and gas formations.

OIL, GAS OR WATER RECORDS

CASING RECORD

FORMATION	CONTENT	FROM	TO	SIZE	PUT IN	PULLED OUT
				8-5/8"	1028'	None
				5-1/2"	3683'	3035'

Describe in detail the manner in which the well was plugged, indicating where the mud fluid was placed and the method or methods used in introducing it into the hole. If cement or other plugs were used, state the character of same and depth placed, from _____ feet to _____ feet for each plug set.

Plugged off bottom with sand to 3452' and dumped 3 Sacks Cement from 3452' to 3428'
Shotoff casing @ 3035'
Filled hole with heavy mud to 1028'
Spotted 30 Sacks Cement from 1028' to 928'
Dumped 10' Rock from 40' to 30'
Spotted 10 Sacks Cement in top of 8-5/8" Casing

STAMP: FEB 2 1958
CONSERVATION DIVISION
WICHI
SIGN

(If additional description is necessary, use BACK of this sheet)
Name of Plugging Contractor J.O. Forbes, dba Forbes Casing Pulling Company
Address Box 221, Great Bend, Kansas

STATE OF Kansas, COUNTY OF Barton, SS.
Ernest Higgins (employee of owner) or (owner or operator) of the above-described well, being first duly sworn on oath, says: That I have knowledge of the facts, statements, and matters herein contained and the log of the above-described well as filed and that the same are true and correct. So help me God.

(Signature) Ernest Higgins
Box 197, Great Bend, Kansas
(Address)

SUBSCRIBED AND SWORN to before me this 7th day of February, 19 58

Charles W. Anderson
Notary Public.

My commission expires November 21, 1961

PLUGGING
FILE SEC 17 T 8 R 23 W
BOOK PAGE 44 LINE 38

15-065-02466-00-00

DRILLERS' LOG

Well Owner: Amerade Petroleum Corporation
Farm Name: R. C. Bethell #1
Commenced: 12/13/57
Completed: 12/23/57
Total Depth: 3685'
Casing: 3 5/8" @ 1023' cemented
 5 1/2" @ 3683' cemented
Elevation:
Production:
Contractor: Glenn W. Peel

Figures below indicate bottoms of formations:

Surface soil	0 -	295
Sand and shale		315
Shale and shells		715
Sand, shale and shells		890
Shale		1030
Shale and sand		1355
Sand		1570
Red bed		1823
Anhydrite		1840
Lime		1855
Shale and shells		2325
Shale		2430
Shale and lime		2545
Lime		2690
Shale and lime		3170
Lime		3685
Total Depth		3685

This is to certify that the above information is to the best of our knowledge true and correct.

GLENN W. PEEL

BY: Al. H. Smith

SUBSCRIBED AND SWORN to before me this 26th day of December, 1957

My commission expires: April 27, 1960

Litch Brant
Notary Public

