


STATE OF KANSAS  
STATE CORPORATION COMMISSION

Give All Information Completely  
Make Required Affidavit  
Mail or Deliver Report to:  
Conservation Division  
State Corporation Commission  
211 No. Broadway  
Wichita, Kansas

15-065-02636-00-00  
WELL PLUGGING RECORD

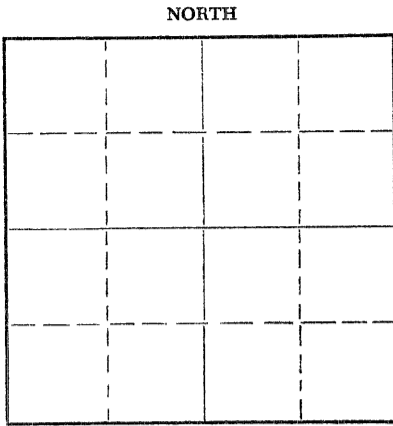

Locate well correctly on above  
Section Plat

Graham County, Sec. 17 Twp. 8S Rge. (E) 23 (W)  
Location as "NE/CNW/SW" or footage from lines SW NE NW  
Lease Owner John O. Farmer, Inc.  
Lease Name ELLSWORTH Well No. 4  
Office Address Russell, Kansas  
Character of Well (completed as Oil, Gas or Dry Hole) Dry  
Date well completed 1/23 1959  
Application for plugging filed 1/23 1959  
Application for plugging approved 1/23 1959  
Plugging commenced 1/23 1959  
Plugging completed 1/23 1959  
Reason for abandonment of well or producing formation Dry

If a producing well is abandoned, date of last production 19  
Was permission obtained from the Conservation Division or its agents before plugging was commenced? yes

Name of Conservation Agent who supervised plugging of this well Fabricius, Hill City, Kansas  
Producing formation \_\_\_\_\_ Depth to top \_\_\_\_\_ Bottom \_\_\_\_\_ Total Depth of Well 3725 Feet  
Show depth and thickness of all water, oil and gas formations.

OIL, GAS OR WATER RECORDS

CASING RECORD

FORMATION	CONTENT	FROM	TO	SIZE	PUT IN	PULLED OUT
				8-5/8"	162'	None

Describe in detail the manner in which the well was plugged, indicating where the mud fluid was placed and the method or methods used in introducing it into the hole. If cement or other plugs were used, state the character of same and depth placed, from \_\_\_\_\_ feet to \_\_\_\_\_ feet for each plug set.

First plug set at 600 feet with 20 sacks cement  
Second plug set at 160 feet with 20 sacks cement  
Third plug set at 40 feet with 1/2 sack hulls and 10 sacks cement

RECEIVED  
STATE CORPORATION COMMISSION  
FEB 4 1959  
CONSERVATION DIVISION  
Wichita, Kansas  
2/4/59

(If additional description is necessary, use BACK of this sheet)  
Name of Plugging Contractor JOHN O. FARMER, INC.  
Address Russell, Kansas

STATE OF Kansas, COUNTY OF Russell, ss.  
I, JOHN O. FARMER (owner or operator) of the above-described well, being first duly sworn on oath, says: That I have knowledge of the facts, statements, and matters herein contained and the log of the above-described well as filed and that the same are true and correct. So help me God.

(Signature) John O. Farmer  
Russell, Kansas (Address)

SUBSCRIBED AND SWORN TO before me this 2nd day of February, 19 59

My commission expires October 11, 1962

Lucille Kennedy  
Lucille Kennedy Notary Public.

PLUGGING  
FILE SEC 17 T. 8. R. 23W  
BOOK 16 LINE 37

