

15-065-03095-0000

STATE OF KANSAS  
STATE CORPORATION COMMISSION

Form CP-4

WELL PLUGGING RECORD

Information Completely  
Required Affidavit  
or Deliver Report to:  
Conservation Division  
State Corporation Commission  
211 No. Broadway  
Wichita, Kansas

Graham County, Sec. 17 Twp. 8 Rge. 23 (E) W (W)

Location as "NE/CNW/SW" or footage from lines CE/2 W/2 NW

Lease Owner Leo J. Dreiling Oil Co.

Lease Name Ellsworth Well No. 1

Office Address Victoria, Kansas

Character of Well (completed as Oil, Gas or Dry Hole) Oil

Date well completed 19 19

Application for plugging filed Jan 28 19 63

Application for plugging approved Jan 31 19 63

Plugging commenced Feb 6 19 63


Plugging completed Feb 7 19 63

Reason for abandonment of well or producing formation Fish in Hole

Could not be recovered

If a producing well is abandoned, date of last production 19

Was permission obtained from the Conservation Division or its agents before plugging was commenced? Yes

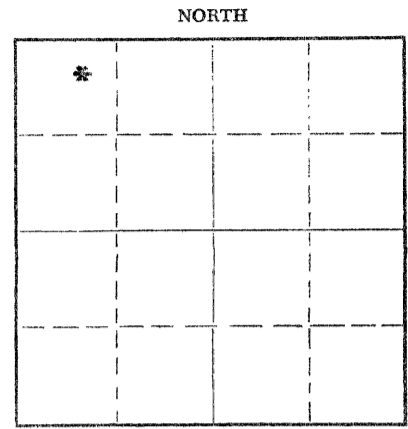

Locate well correctly on above Section Plat

Name of Conservation Agent who supervised plugging of this well W. L. Nichols Moreland, Ks.

Producing formation Depth to top Bottom Total Depth of Well 3710 Feet

Show depth and thickness of all water, oil and gas formations.

OIL, GAS OR WATER RECORDS

CASING RECORD

FORMATION	CONTENT	FROM	TO	SIZE	PUT IN	PULLED OUT
				8 5/8	205	none
				5 1/2	3709	801'

Describe in detail the manner in which the well was plugged, indicating where the mud fluid was placed and the method or methods used in introducing it into the hole. If cement or other plugs were used, state the character of same and depth placed, from feet to feet for each plug set.

Top of fish at 1000' could not be recovered, pulled 800' of 5 1/2 csg to 650' mixed and pumped gel mud, would not circulate pulled to 450' mixed and circulated 20 sx gel mud, with pump, mixed and pumped in 20 sx cem from 400' to 340' pulled csg to 200' mixed and pumped in 20 sx cem from 200' to 140' pulled csg, filled hole with mud to 40' set 10' rock bridge Mixed and put in 10 sx cem fill to base of cellar.

RECEIVED  
STATE CORPORATION COMMISSION

FEB 25 1963

2/25/63

(If additional description is necessary, use BACK of this sheet)

Name of Plugging Contractor Ace Pipe Pulling Co License NO. 2

Address Great Bend, Kansas

STATE OF Kansas, COUNTY OF Ellis, ss.

I, Leo J. Dreiling a partner (employee of owner) or (owner or operator) of the above-described well, being first duly sworn on oath, says: That I have knowledge of the facts, statements, and matters herein contained and the log of the above-described well as filed and that the same are true and correct. So help me God.

(Signature) Leo J. Dreiling

(Address)

SUBSCRIBED AND SWORN TO before me this 21 day of February, 19 63

My commission expires August 14, 1965 Notary Public.



15-065-03095-0000  
DRILLERS LOG

#1 Ellsworth

CASING RECORD:  
 205' of used 8-5/8" surface casing

COMPANY: Leo J. Drilling Oil Co.

DESCRIPTION:  
 C/E/2 W/2 NW/4  
 Section 17-8-23W  
 Graham County, Kansas  
 ELEVATION: 2241' DF

TOTAL DEPTH:  
 3710'

COMMENCED: December 6, 1958  
 COMPLETED: December 16, 1958

<u>FORMATION</u>	<u>FROM</u>	<u>TO</u>	<u>REMARKS</u>
Clay, Sand & Shale	0	205	Ran 205' (10 joints) of used 8-5/8" surface casing; cemented with 150 sacks of cement, 2% Gel and 2% C. C..
Shale	205	950	
Sand	950	985	
Sand & Shale	985	1190	
Shale & Shells	1190	1890	
Anhydrite	1890	1929	
Shale & Shells	1929	2510	
Shale & Lime	2510	2950	
Lime	2950	3040	
Shale & Lime	3040	3710	Ran 123' of 5 1/2" O. D. casing; cemented with 125 sacks of cement.

TOTAL DEPTH 3710'

STATE COMMISSIONER OF GEOL. & MIN.

FEB 25 1963

CONSERVATION DIVISION  
 Wichita, Kansas

STATE OF KANSAS )  
 ) ss:  
 COUNTY OF BARTON )

2/25/63

I certify that this is a true and correct copy of the above log to the best of my knowledge.

STRATA DRILLING, INC.

*Charles W. Steincamp*  
 Charles W. Steincamp, Pres.

Subscribed and sworn to before me this 18th day of December, 1958.

*Elaine H. Taylor*  
 Elaine H. Taylor, Notary Public

My Commission Expires:

December 14, 1961