

15-065-03096-0020

WELL PLUGGING RECORD

Give All Information Completely  
Make Required Affidavit  
Mail or Deliver Report to:  
Conservation Division  
State Corporation Commission  
511 No. Broadway  
Wichita, Kansas

Graham County, Sec. 17 Twp. 8 Rge. 23 (E) W (W)  
Location as "NE/CNW/SW" or footage from lines SW NW NW

Lease Owner Leo J. Dreiling Oil Co.

Lease Name Ellsworth Well No. 2

Office Address Victoria, Kansas.

Character of Well (completed as Oil, Gas or Dry Hole) Oil

Date well completed \_\_\_\_\_ 19. 63 X

Application for plugging filed Jan 28 1963

Application for plugging approved Jan 31 1963


Plugging commenced Feb 2 1963

Plugging completed feb 5 1963

Reason for abandonment of well or producing formation Depleted

If a producing well is abandoned, date of last production \_\_\_\_\_ 19. 63 X

Was permission obtained from the Conservation Division or its agents before plugging was commenced? Yes

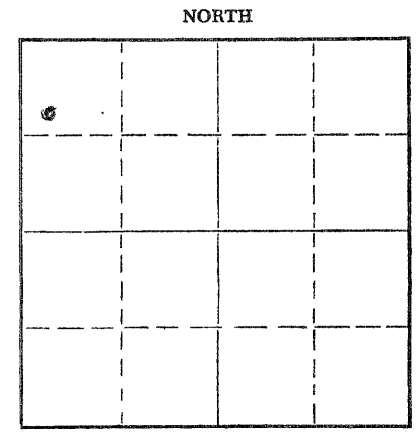

Locate well correctly on above Section Plat

Name of Conservation Agent who supervised plugging of this well W. L. Nichols Moreland, Ks.

Producing formation Arb. Depth to top \_\_\_\_\_ Bottom \_\_\_\_\_ Total Depth of Well 3685 Feet

Show depth and thickness of all water, oil and gas formations.

OIL, GAS OR WATER RECORDS

CASING RECORD

FORMATION	CONTENT	FROM	TO	SIZE	PUT IN	PULLED OUT
				8 5/8	191	none
				5 1/2	3684	3080'

Describe in detail the manner in which the well was plugged, indicating where the mud fluid was placed and the method or methods used in introducing it into the hole. If cement or other plugs were used, state the character of same and depth placed, from \_\_\_\_\_ feet to \_\_\_\_\_ feet for each plug set.

Plug back with sand to 3540' mix and dump 4 sx cem from 3540' to ~~3505'~~ 3505' pulled # 5 1/2 esg to 500' mixed and circulated 20 sx gel mud (with pump) mixed and pumped 20 sx cem from 500' to 450' pulled casing to 180' mixed and pumped in 20 sx cem from 180' to 120' pulled esg out filled hole with mud to 40' set 10' rock ~~bridge~~ bridge mixed and put in 10 sx cem fill to base of cellar.

STATE CORPORATION COMMISSION

FEB 25 1963

CONSERVATION DIVISION

2/25/63

Name of Plugging Contractor Ace Pipe Pulling Co License No. 2

Address Great Bend Kansas.

STATE OF Kansas, COUNTY OF Ellis, ss. Leo J. Dreiling a partner (employee of owner) or (owner or operator) of the above-described well, being first duly sworn on oath, says: That I have knowledge of the facts, statements, and matters herein contained and the log of the above-described well as filed and that the same are true and correct. So help me God.

(Signature) Leo J. Dreiling

(Address)

SUBSCRIBED AND SWORN TO before me this 21 day of February, 1963

Kenard Zimmerman

Notary Public.

My commission expires August 14, 1965



L. J. DREILING and SONS, Inc.

VICTORIA, KANSAS

15-665-03096-00-00  
WELL LOG

Company Leo J. Dreiling Oil Company Sec. 17 Twp. 8 Rng. 23  
 Victoria, Kansas  
 Farm Ellsworth No. 2 Location SW NW NW  
 Total Depth 3685' County Graham County, Kansas  
 Comm. February 14, 1962 Comp. February 20, 1962 Elevation: D. F. 2253'  
 Contractor L. J. DREILING & SONS, INC. G. R. 2251'  
 VICTORIA, KANSAS

Casing Record	Cement Record	Production:
3 5/8" - - - 191'	150 sacks cement	Arbuckle
5 1/2" - - - - 3685'	80 sacks pos-mix	
	10 " strata crete	
	15 " salt	

Figures Indicate Bottom of Formations

0 - 40	Surface Clay
40 - 191	Shale & Clay
191 - 936	Shale & Sand
936 - 1851	Shale & Shells
1851 - 1903	Red Rock Shale
1903 - 1935	Anhydrite
1935 - 2315	Shale & Lime Shells
2315 - 2582	Lime & Shale
2582 - 2787	Shale & Lime
2787 - 2939	Lime & Shale
2939 - 3100	Lime & Shale
3100 - 3280	Shale & Lime
3280 - 3415	Lime & Shale
3415 - 3470	Lime & Shale
3470 - 3560	Shale & Lime
3560 - 3580	Lime
3580 - 3615	Lime
3615 - 3685	Lime
3685	TD

STATE COMMISSIONER OF GEOL.

FEB 25 1963

STATE OF KANSAS )  
 ) ss.  
 COUNTY OF ELLIS )

CONSERVATION ENGINEER  
Victoria, Kansas

2/25/63

I, Leo F. Dreiling, of the L. J. Dreiling and Sons, Inc., upon oath states that the above and foregoing is a true and correct copy of the log from the Daily Drilling Report on your Ellsworth No. 2.

*Leo F. Dreiling*  
 LEO F. DREILING

Subscribed and sworn to before me this 7th day of March, 1962

*Ronald Zimmerman*  
 NOTARY PUBLIC

My Commission Expires: August 14, 1965