


STATE OF KANSAS
STATE CORPORATION COMMISSION

WELL PLUGGING RECORD

Give All Information Completely
Make Required Affidavit
Mail or Deliver Report to:
Conservation Division
State Corporation Commission
211 No. Broadway
Wichita, Kansas

Graham County. Sec. 19 Twp. 8 Rge. 23 (E) W (W)
Location as "NE/CNW/SW" or footage from lines SE NE NE
Lease Owner Leo J. Dreiling Oil Co.
Lease Name Higer B Well No. 1
Office Address Victoria, Kans.
Character of Well (completed as Oil, Gas or Dry Hole) Oil
Date well completed _____ 19____
Application for plugging filed August 17 1962
Application for plugging approved August 23 1962
Plugging commenced August 20 1962
Plugging completed August 29 1962
Reason for abandonment of well or producing formation _____
no longer a producer
If a producing well is abandoned, date of last production _____ 19____
Was permission obtained from the Conservation Division or its agents before plugging was commenced? yes

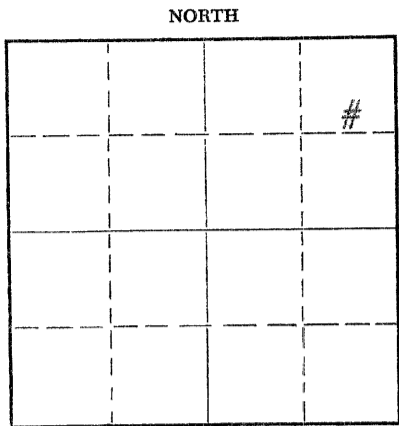

Locate well correctly on above Section Plat

Name of Conservation Agent who supervised plugging of this well Eldon Petty
Producing formation _____ Depth to top _____ Bottom _____ Total Depth of Well _____ Feet
Show depth and thickness of all water, oil and gas formations.

OIL, GAS OR WATER RECORDS

CASING RECORD

FORMATION	CONTENT	FROM	TO	SIZE	PUT IN	PULLED OUT
				8 5/8	182'	none
				5 1/2	3739 1/2	2439'

Describe in detail the manner in which the well was plugged, indicating where the mud fluid was placed and the method or methods used in introducing it into the hole. If cement or other plugs were used, state the character of same and depth placed, from _____ feet to _____ feet for each plug set.

Plugged back with sand from 3740' to 3670'. Mixed and dumped 4 sx cement from 3670' to 3638'. Pulled casing to 450'. Mixed and circulated 20 sx of gel mud. Mixed and pumped in 20 sx cement from 450' to 390'. Pulled casing to 180'. Mixed and pumped in 20 sx cement from 180' to 120'. Pulled rest of casing. Bailed off gel to 35'. Set 5' rock bridge from 35' to 30'. Mixed and dumped 10 sx cement from 30' to base of the cellar.

RECEIVED
STATE CORPORATION COMMISSION

SEP 1 1962

CONSERVATION DIVISION
Wichita, Kansas

(If additional description is necessary, use BACK of this sheet)
Name of Plugging Contractor Ace Pipe Pulling Co.
Address Box 304 Great Bend, Kansas

9/1/62

STATE OF Kansas, COUNTY OF Ellis, ss.
I, Leo J. Dreiling a partner (employee of owner) or (owner or operator) of the above-described well, being first duly sworn on oath, says: That I have knowledge of the facts, statements, and matters herein contained and the log of the above-described well as filed and that the same are true and correct. So help me God.

(Signature) Leo J. Dreiling

(Address)

SUBSCRIBED AND SWORN TO before me this 8 day of September, 1962

Roman Zimmerman

Notary Public.

My commission expires August 14, 1965



15-065-02979-00-00

SIDEY DRILLING CO.

BUILDING & LOAN BLDG. P. O. BOX 387

RUSSELL, KANSAS

Company **Leo J. Dreiling Oil Company**

Sec. 19 T. 8 R. 23W

Farm **Higer** No. 1

Loc. **SE NE NE**

Total Depth **3743 RTD**

Comm. **4-22-57**

Comp. **5-4-57**

County **Graham**

Shot or Treated

Contractor **Sidey Drilling Company**

Issued

Casing

20	10	
15½	8¼	180'
12½	6%	
13%	5 5/16	

Elevation

Production

Figures Indicate Bottom of Formations

0-50	Sand
50-182	Shale
182-1000	Shale
1000-1175	Shale & shells
1175-1185	Grey sand
1185-1325	Shale & shells
1325-1460	Red bed
1460-1900	Shale & red bed
1900-1938	Anhydrite
1938-2300	Shale & shells
2300-2450	Shale & lime shells
2450-2575	Shale & lime shells
2575-2750	Shale & lime
2750-2780	Sandy shale
2780-2810	Shale & lime streaks
2810-3065	Shale & lime
3065-3155	Broken lime
3155-3485	Lime & shale
3485-3580	Lime
3580-3670	Lime
3670-3703	Lime
3703-3743	Lime RTD

9/10/62
RECEIVED
 STATE CORPORATION COMMISSION

SEP 10 1962

CONSERVATION DIVISION
Wichita, Kansas

STATE OF KANSAS, COUNTY OF RUSSELL, ss

I, V. D. Sidey, of the Sidey Drilling Company, upon oath states that the above and foregoing is a true and correct copy of the Daily Drilling Report on your Higer #1 Well.

V. D. Sidey

 V. D. Sidey

Subscribed and sworn to before me this 21st day of May, 1957.

Marguerite Beyond

 NOTARY PUBLIC

My Commission Expires: September 17, 1960