



15-121-28530-0000

Kansas Corporation Commission

Bill Graves, Governor John Wine, Chair Cynthia L. Claus, Commissioner Brian J. Moline, Commissioner

February 9, 2007

Meredith Pearce
Osborn Energy, LLC
24850 Farley
Bucyrus, KS 66013

RE: Notice of Intent To Drill
Hopkins #17-1
2310' FSL, 1650 FWL, Sec. 1-T16S-R24E
Miami County

Dear Ms. Pearce,

Our records indicate that a domestic water well is located within approximately 628 feet of the referenced proposed location. Eastern Kansas Surface Casing Order #133,891-C for Area 2, paragraph 2 states, "**No well shall be drilled closer than 660 feet of an existing domestic or municipal water well without written owner notification, a copy of which must be attached to the drilling intent form during filing. Special casing and cementing requirements may be imposed in those areas producing fresh and usable water.**"

Please provide us with a copy of the owner notification to further the processing of your notice of intent to drill. The records indicate this water well has a total depth of 260 feet and water level of 120 feet.

Sincerely,

Rick Hestermann
Production Department

cc: Steve Korf, District 3

RECEIVED
KCC DISTRICT #3

FEB 12 2007

CHANUTE, KS

RECEIVED

MAR 26 2007

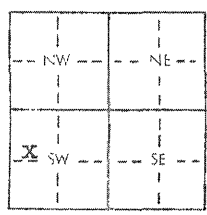
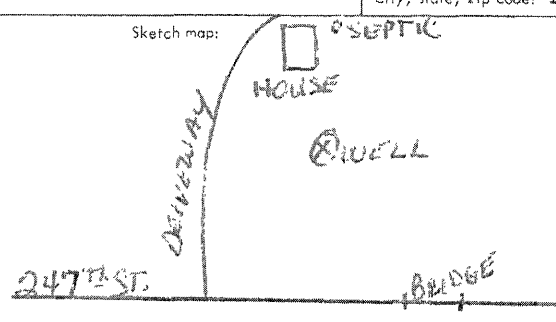
KCC WICHITA

15-12-28530-0000

USE TYPEWRITER OR BALL POINT PEN-PRESS FIRMLY, PRINT CLEARLY.

WATER WELL RECORD
KSA 82a-1201-1215

Kansas Department of Health and Environment-Division of Environment
(Water well Contractors)
Topeka, Kansas 66620

1. Location of well:		County Miami	Fraction SW 1/4 NE 1/4 SW 1/4	Section number 1	Township number T 16S	Range number R 24E
2. Distance and direction from nearest town or city: 3 miles southeast of Bucyrus				3. Owner of well: Gary Smith R.R. or street: R.R. City, state, zip code: Bucyrus, Kansas		
4. Locate with "X" in section below:		Sketch map:			6. Bore hole dia. 6 1/8 in. Completion date 4/14/79 Well depth 260 ft.	
					7. <input checked="" type="checkbox"/> Cable tool <input checked="" type="checkbox"/> Rotary <input type="checkbox"/> Driven <input type="checkbox"/> Dug <input type="checkbox"/> Hollow rod <input type="checkbox"/> Jetted <input type="checkbox"/> Bored <input type="checkbox"/> Reverse rotary	
5. Type and color of material					8. Use: <input type="checkbox"/> Domestic <input type="checkbox"/> Public supply <input type="checkbox"/> Industry <input type="checkbox"/> Irrigation <input type="checkbox"/> Air conditioning <input type="checkbox"/> Stock <input checked="" type="checkbox"/> Lawn <input type="checkbox"/> Oil field water <input type="checkbox"/> Other	
					9. Casing: Material: _____ Height: Above or below Threaded _____ Welded <input checked="" type="checkbox"/> Surface 12 in. RMP _____ PVC <input checked="" type="checkbox"/> Weight 1.3 lbs./ft. Dia. 4 1/2 in. to 260 ft. depth Wall thickness: inches or Dia. _____ in. to _____ ft. depth Section No. 200	
					10. Screen: Manufacturer's name _____ Jess & Lowell Type plastic Dia. 4 1/2 Slot/groove 1/8" Length 20' Set between 220 ft. and 240 ft. ft. and _____ ft. Gravel pack? <input checked="" type="checkbox"/> Yes Size range of material 1/4 x 1/8"	
					11. Static water level: _____ mo./day/yr. 120 ft. below land surface Date 4/4/79	
					12. Pumping level below land surfaces: _____ ft. after _____ hrs. pumping _____ g.p.m. _____ ft. after _____ hrs. pumping _____ g.p.m. Estimated maximum yield _____ g.p.m.	
					13. Water sample submitted: _____ mo./day/yr. Yes <input checked="" type="checkbox"/> No _____ Date _____	
					14. Well head completion: <input checked="" type="checkbox"/> Pitless adapter 12 inches above grade	
					15. Well grouted? <input checked="" type="checkbox"/> Yes With: <input checked="" type="checkbox"/> Neat cement <input type="checkbox"/> Bentonite <input type="checkbox"/> Concrete Depth: From 15 ft. to 3 ft.	
					16. Nearest source of possible contamination: ft. 200 Direction NE Type septic Well disinfected upon completion? <input checked="" type="checkbox"/> Yes _____ No _____	
					17. Pump: <input checked="" type="checkbox"/> Not installed Manufacturer's name _____ Model number _____ HP _____ Volts _____ Length of drop pipe _____ ft. capacity _____ g.p.m. Type: <input type="checkbox"/> Submersible <input type="checkbox"/> Turbine <input type="checkbox"/> Jet <input type="checkbox"/> Reciprocating <input type="checkbox"/> Centrifugal <input type="checkbox"/> Other	
18. Elevation: 990		19. Remarks: Customer is aware of state regulation and agrees to install a 4' square re-enforced concrete platform around top of well. <i>Gary Smith</i>			20. Water well contractor's certification: This well was drilled under my jurisdiction and this report is true to the best of my knowledge and belief. F.E. Young Drilling Co., Inc. Business name License No. _____ Address 6355 Robinhood Ln. Date 6/19/79 Authorized representative _____	

Forward the white, blue and pink copies to the Department of Health and Environment

RECEIVED KCC DISTRICT #3 Date 6/19/79

FEB 12 2007

RECEIVED

CHANUTE, KS

MAR 26 2007

KCC WICHITA

T 16 S R 24 E SW 1/4

KCC OIL/GAS REGULATORY OFFICES

15-121-28530-000

Date 20-Feb-07 New Situation
 Response to Request
 Follow-up

Qtr, Qtr SW Sec. 1 Twp. 16 Rge. 24

Operator Osborn Energy, LLC License # 32294

Address 24850 Farley

Address Bucyrus, KS 66013 Lease/Well # Hopkins

Phone # (913) 533-9900 County Miami

Lease Inspection Complaint Field Report

Problem Intent location for CBM well possibly within 660 feet of domestic ground water well.

Persons Contacted _____

Findings Using the sketch map provided on the WWC5 water well record and the legal description, a domestic ground water well was found at the following location: SE SW SW Sec. 1, T16S, R24E.

The house/property (10788 W. 247th St., Bucyrus, KS) where the well is located is owned by Jim Hartmann (phone: 913-710-1710). It appears that the quarter calls and the location of the well on the section drawing (marked with "X") on the WWC5 are wrong. The actual location of the ground water well is greater than 660 feet from the proposed Hopkins #17-1 intent location.

Photos Taken NO

Actions/Recommendations GPS well location: HOP01 (see attached map). 38.68081667, 94.71010000. Contact Ms. Merideth Pearce at Osborn Energy to inform her that the Hopkins #17-1 intent location is not within the 660 foot range of a ground water well.

By: Levi Short (PIRT)

RECEIVED

MAR 26 2007

KCC WICHITA

