


STATE OF KANSAS
STATE CORPORATION COMMISSION

15-163-19367-00-00

WELL PLUGGING RECORD

Give All Information Completely
Make Required Affidavit
Mail or Deliver Report to:
Conservation Division
State Corporation Commission
211 No. Broadway
Wichita, Kansas

Rooks County. Sec. 26 Twp. 10 Rge. 20 (W)
Location as "NE/CNW/SW" or footage from lines 990' N 1650' W of S/4 corner
Lease Owner Cities Service Oil Co.
Lease Name Armbrister "B" Well No. 1
Office Address Bartlesville, Oklahoma
Character of Well (completed as Oil, Gas or Dry Hole) dry hole
Date well completed 9/22 19 57
Application for plugging filed 9/23 19 57
Application for plugging approved 9/24 19 57
Plugging commenced 9/22 19 57
Plugging completed 9/22 19 57
Reason for abandonment of well or producing formation -

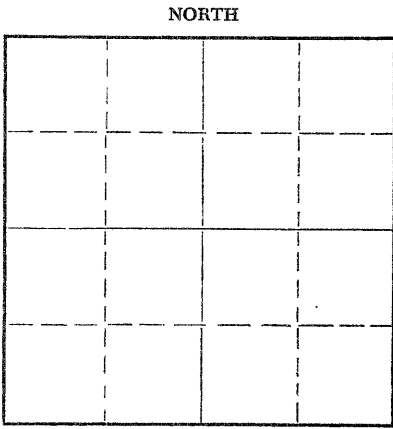

Locate well correctly on above Section Plat

If a producing well is abandoned, date of last production - 19 -
Was permission obtained from the Conservation Division or its agents before plugging was commenced? yes

Name of Conservation Agent who supervised plugging of this well Mr. Eldon Petty
Producing formation _____ Depth to top _____ Bottom _____ Total Depth of Well 3860 Feet
Show depth and thickness of all water, oil and gas formations.

OIL, GAS OR WATER RECORDS

CASING RECORD

FORMATION	CONTENT	FROM	TO	SIZE	PUT IN	PULLED OUT
				8-5/8"	260'	none

Describe in detail the manner in which the well was plugged, indicating where the mud fluid was placed and the method or methods used in introducing it into the hole. If cement or other plugs were used, state the character of same and depth placed, from _____ feet to _____ feet for each plug set.

Filled hole with heavy mud to 600'. Mixed and spotted 20 sacks cement at 600' through drill pipe. Filled hole with heavy mud to 240', mixed and spotted 20 sacks cement at 240' through drill pipe. Filled hole with mud to 40'. Set Howco plug with one-half sack hulls at 40' and filled hole to surface with 10 sacks cement.

RECEIVED
STATE CORPORATION COMMISSION
OCT 8 1957
10-08-1957
CONSERVATION DIVISION
Wichita, Kansas

(If additional description is necessary, use BACK of this sheet)
Name of Plugging Contractor Glenn W. Peel Drilling Co.
Address Hoisington, Kansas

STATE OF KANSAS, COUNTY OF BARTON, ss.
M. M. Hardin (employee of owner) or (owner or operator) of the above-described well, being first duly sworn on oath, says: That I have knowledge of the facts, statements, and matters herein contained and the log of the above-described well as filed and that the same are true and correct. So help me God.

(Signature) M. M. Hardin
Box 553, Russell, Kansas (Address)

SUBSCRIBED AND SWORN TO before me this 26th day of Sept., 19 57
N. G. Smith Notary Public.

My commission expires 3-17-1959

PLUGGING
FILE SEC 26 T 10 R 20
BOOK PAGE 48 LINE 20

WELL RECORD

15-163-19367-00-00

WILDCAT.....

DISCOVERY.....

POOL.....

COMPANY Cities Service Oil Co. WELL # 1 FARM Armbrister "B"

LOCATION 990' N. and 1650' W. of S/4 Corner, Section 26, Township 10, Range 20N.

ELEV. 2179 (217A Gr.) CO. Books STATE Kansas

IP. Dry hole. P. and A. September 22, 1957.

PERFS.

FRAC. ACID None

T.D. 3860' PBTD GRAV/GOR.....

DRLG. COMM. September 9, 1957 COMP. September 22, 1957 CONTRACTOR Glenn W. Peol

CASING RECORD:

8-5/8" at 260' with 175 sacks cement.

FORMATION RECORD:

sand and shale	0-260
shale	1050
shale and shells	1610
anhydrite	1655
shale and shells	1845
shale	2120
shale and lime	2285
lime	2560
shale and lime	2700
lime and shale	2810
lime	2830
lime and shale	2940
shale and lime	3240
lime	3735
lime and conglomerate	3755
lime and chert	3846
chert and lime	3860 T.D.

Heebner	3421
Dodge	3445
Lansing	3456
Base Kansas City	3686
Conglomerate	3720
Simpson Shale	3801
Arbuckle	3846
Pen.	14'
T.D.	3860

D.S.T. 3475-3505, open 30 minutes, rec. 20' slightly oil-specked mud; B.H.P. 1222# in 30 minutes.

D.S.T. 3510-45, open 1 hour, rec. 160' slightly oil-specked muddy water; B.H.P. 1074# in 30 minutes.

Slope Tests (Syfo):

- 1500' - 1°
- 2000' - 1°
- 3000' - 0°

7-7/8" Rotary hole.

PLUGGING

FILE SEC. 26 T. 10 R. 20W
 BOOK PAGE 48 LINE 20

RECEIVED
 STATE COMMISSION
 DIVISION
 Wichita, Kansas
 OCT 10 1957
 10-08-1957