

WELL PLUGGING RECORD

All Information Completely
Required Affidavit
Mail or Deliver Report to
Conservation Division
State Corporation Comm.
200 Colorado Derby Bldg.
202 W. 1st St.
Wichita, KS 67202

Rooks County Sec. 17 Twp. 10s Rge. 20
Location as "NE/CNW/SW" or footage from lines
SW NE NW

Lease Owner Liberty Enterprises

Lease Name Keller "A" Well No. #1

Office Address 308 West Mill Plainville, Ks 67663

Character of Well (Completed as Oil, Gas or Dry Hole)
Dry Hole

Date Well completed November 11 1981

Application for plugging filed November 11 1981

Application for plugging approved November 11 1981

Plugging commenced 3:30 P.M. November 11 1981

Plugging completed 4:30 P.M. November 11 1981

Reason for abandonment of well or producing formation
No Commercial Production


If a producing well is abandoned, date of last production
19

Was permission obtained from the Conservation Division or
its agents before plugging was commenced? Yes

Name of Conservation Agent who supervised plugging of this well Marion Schmidt

Producing formation Depth to top Bottom Tl. Depth of Well

Show depth and thickness of all water, oil and gas formations.

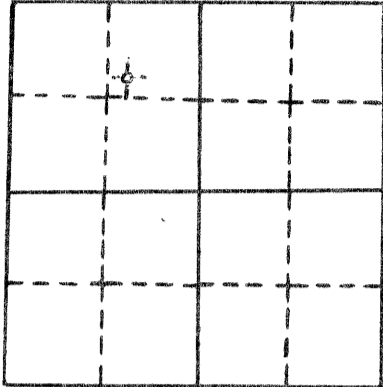

locate well correctly
on above
Section Plot

OIL, GAS OR WATER RECORDS

CASING RECORD

FORMATION	CONTENT	FROM	TO	SIZE	PUT IN	PULLED OUT
Surface	common	230'	231'	8 5/8"	231'	0'

Describe in detail the manner in which the well was plugged, indicating where the mud fluid
was placed and the method or methods used in introducing it into the hold. If cement or other
plugs were used, state the character of same and depth placed, from feet to
feet for each plug set.

Plug #1 960' with 70sxs

Plug #2 220' with 40sxs

Plug #3 40' with 10sxs

RECEIVED
STATE CORPORATION COMMISSION
12-07-1981
DEC - 7 1981

10sxs in rathole

Total-----130sxs 50-50pos 6%gel

P.D. @ 4:30 P.M.

CONSERVATION DIVISION

(If additional description is necessary, use BACK of this sheet)

Name of Plugging Contractor Pioneer Drilling Company
308 West Mill Plainville, KS 67663

STATE OF Kansas COUNTY OF Rooks, ss.


David L. Comeau (employee of owner) or (owner or operator) of the
above described well, being first duly sworn on oath, says: That I have knowledge of the
facts, statements, and matters herein contained and the log of the above described well
is filed and that the same are true and correct. So help me God.

(Signature) David L. Comeau

(Address) 308 West Mill
Plainville, Kansas 67663

SUBSCRIBED AND SWORN TO before me this 4th day of December, 1981

My commission expires

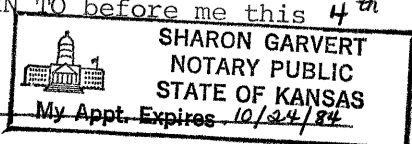

Sharon Garvert
Sharon Garvert Public