

STATE OF KANSAS  
STATE CORPORATION COMMISSION


WELL PLUGGING RECORD

Information Completely  
Required Affidavit  
Mail or Deliver Report to:  
Conservation Division  
State Corporation Commission  
800 Bittling Building  
Wichita, Kansas

Graham County, Sec. 34 Twp. 9S Rge. 21 (W)

Location as "NE/CNW $\frac{1}{4}$ /SW $\frac{1}{4}$ " or footage from lines SE $\frac{1}{4}$   
Lease Owner Phillips Petroleum Company  
Lease Name Desair Well No. 5  
Office Address Box 779, Great Bend, Kansas  
Character of Well (completed as Oil, Gas or Dry Hole) Dry Hole  
Date well completed March 21, 19 52  
Application for plugging filed March 6, 19 52  
Application for plugging approved March 7, 19 52  
Plugging commenced March 21, 19 52  
Plugging completed March 21, 19 52  
Reason for abandonment of well or producing formation Dry Hole

NORTH

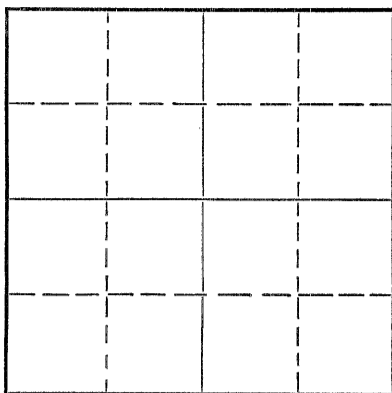

Locate well correctly on above  
Section Plat

If a producing well is abandoned, date of last production - 19  
Was permission obtained from the Conservation Division or its agents before plugging was commenced? Yes

Name of Conservation Agent who supervised plugging of this well Mr. Eldon Petty  
Producing formation Arbuckle Depth to top 3870 Bottom 3890 Total Depth of Well 3890 Feet  
Show depth and thickness of all water, oil and gas formations.

OIL, GAS OR WATER RECORDS

CASING RECORD

Formation	Content	From	To	Size	Put In	Pulled Out
Howard	Dry	3294		8-5/8"	339.11	None
Topeka	Dry	3325		5-1/2"	3899.00	1888.00'
Heebner	Dry	3503				
Toronto	Dry	3525				
Lansing-Kansas City	Dry	3544	3769			
Arbuckle	Dry	3870	3890			

Describe in detail the manner in which the well was plugged, indicating where the mud fluid was placed and the method or methods used in introducing it into the hole. If cement or other plugs were used, state the character of same and depth placed, from \_\_\_\_\_ feet to \_\_\_\_\_ feet for each plug set.

Set Lane Wells bridging plug at 3664' - dumped 2 sx. cement on plug. Dumped crushed rock to 3570'. Ran 4 sx. cement in filling to 3540'. Mudded hole to 340'. Set rock bridge, dumped 15 sx. cement, mudded hole to 35'. Set rock bridge, dumped 10 sx. cement in filling to base of cellar. Well plugged and abandoned 4:00 P.M. 3-21-52

(If additional description is necessary, use BACK of this sheet)

Name of Plugging Contractor Miller Casing Pulling Unit  
Address Great Bend, Kansas

STATE OF Kansas, COUNTY OF Barton, ss.  
A. J. Willis (employee of owner) or owner or operator of the above-described well,

being first duly sworn on oath, says: That I have knowledge of the facts, statements, and matters herein contained and the log of the above-described well as filed and that the same are true and correct. So help me God.

(Signature) *A. J. Willis*  
Box 779, Great Bend, Kansas  
(Address)

SUBSCRIBED AND SWORN to before me this 25th day of March, 19 52

*Joseph M. Beal*  
Notary Public.

My commission expires November 18, 1953

PLUGGING  
FILE SEC 34 T 9 R 20W  
BOOK PAGE 148 LINE 26

3-27-52

## Formation Record

Lease Desair

Well No. 5

FROM	TO	Formation	REMARKS
0	297	Sand and shale.	
297	345	Shale.	
345	980	Shale, sand, and Redbed.	
980	1525	Shale and shells.	
1525	1881	Shale, sand, and anhydrite.	
1881	2116	Shale.	
2116	2336	Lime and shale.	
2336	2557	Chalk, shale, and lime streaks.	
2557	2860	Lime and shale.	
2860	3022	Shale and lime streaks.	
3022	3289	Lime and shale.	
3289	3419	Shale and lime streaks.	Tops: Howard 3294 Topeka 3325
3419	3838	Lime and shale.	Heebner 3503 Toronto 3525 LKC 3544 Base 3769
3838	3865	Lime.	
3865	3890	Lime and shale.	Top Arbuckle 3870

PLUGGING

FILE SEC 34 T 9 R 21W  
BOOK PAGE 14 LINE 26